

MISSISSIPPI DEPARTMENT OF NATURAL RESOURCES
Bureau of Land and Water Resources

P.O. Box 10631
Jackson, Mississippi 39209
WATER WELL DRILLERS LOG

COUNTY WELL LOCATED
TATE

WELL NUMBER **E** CODED

2034

DATE WELL COMPLETED
5-24-90

PERMIT NUMBER

HICKS WELL CO.

NAME OF DRILLING FIRM
RT. 1 BOX 157

SENATOBIA, MS 38668

NAME & MAILING ADDRESS OF LANDOWNER
TIM WHITTLE

RT. 2 BOX 107 E

SENATOBIA, MS. 38668

WELL LOCATION: SEC **23** TOWNSHIP **S** RANGE **9** **W**

DISTANCE **10** Miles **W** of **Senatobia**

NEAREST TOWN

OTHER LANDMARK
STRAYHORN

WELL PURPOSE Irrigation, Municipal, Industrial, Fish Pond, etc.

PUMP DATA

PUMP TYPE (Circle One):
 Submersible Turbine, Jet, Flowing Well,
Other (Describe) _____

POWER TYPE (Circle One):
 Electric Tractor, Diesel, Gasoline, Butane,
Other (Describe) _____ H/P **3/4**

Pump Capacity (GPM)	No. of Stages	Setting Depth
10	12	170 FT.

PUMP TEST

Well yielded **10** GPM with
a drawdown of _____ ft.
after _____ hours of pumping

WELL DATA

Well Depth 180	Casing Diameter (In.) 4"	Casing Length (Ft.) 170
Type of Casing PVC	Hole Depth 180	Depth to Static Water Level 130

TYPE OF COMPLETION: (Circle One or More):
 Gravel Packed, Underreamed, Telescoped,
Natural Development, Open Hole, Other
(Describe) _____

Top of Lap Pipe or Reduction in Casing

FEET IF TELESCOPED OR MORE THAN ONE SCREEN: USE BACK PAGE

LOG DATA

TYPE OF LOG RUN (Circle One): No Log Run,
Electric, Gamma Ray, Density, Sonic, Neutron,
Other (Describe) _____

Name of Organization Running Log

SCREEN DATA

Diameter - Inches 4"	Length - Feet 10'	Slot Size - Inches 0.13
Screen Type PVC	Depth to Bottom - Feet 10'	

GEOLOGIC DATA (Office Use Only)

Surface Elev.	Geologic Unit	Unit Thickness	Depth to Top
Subs. SWL	Date	Analysis	Aquifer Test


Driller's Remarks

DESCRIPTION OF FORMATIONS ENCOUNTERED	FROM	TO	FORMATIONS ENCOUNTERED	FROM	TO
RC	0	30	RECEIVED JUN 07 1990 Department of Natural Resources Bureau of Land & Water Resources		
RC + S	30	60			
B-CIAY	60	160			

IF MORE SPACE IS NEEDED, USE BACK

If well telescopes please
sketch and show depths.

GROUND LEVEL

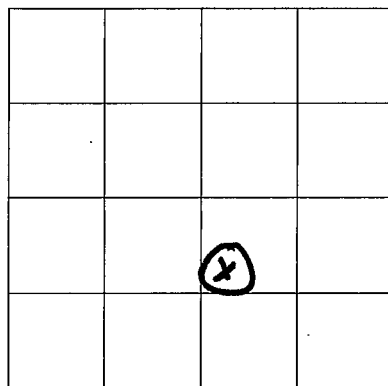

SECTION _____

Please indicate well location X.

ADDITIONAL INFORMATION

If more than one screen,
show location of each on sketch.