

MISSISSIPPI DEPARTMENT OF ENVIRONMENTAL QUALITY

Office of Land and Water Resources

P. O. Box 10631
Jackson, MS 39289-0631
WATER WELL DRILLERS LOG

| | |
|---------------------------------------|-------|
| COUNTY WELL LOCATED JATE | |
| WELL NUMBER E 2058 | CODED |
| DATE WELL COMPLETED 9-21-99 | |

| |
|--|
| PERMIT NUMBER HICKS WELL CO. |
| NAME OF DRILLING FIRM SEN... |

NAME & MAILING ADDRESS OF LANDOWNER
Tony J. or Lisa M. Hetterick

678 BROWNLEE Rd.

SENATOBIA, MS 38668

WELL LOCATION: SEC 26 TOWNSHIP 5 RANGE 9

DISTANCE 1 Miles DIRECTION E of NEAREST TOWN STRAVHORN

OTHER LANDMARK

WELL PURPOSE: Home, Irrigation, Municipal, Industrial, Fish Pond, etc.
shop

PUMP DATA

PUMP TYPE (Circle One):
Submersible Turbine, Jet, Flowing Well, Other (Describe)

POWER TYPE (Circle One):
Electric Tractor, Diesel, Gasoline, Butane, Other (Describe) H/P 1/2

| | | |
|----------------------------------|---------------|--------------------------------|
| Pump Capacity (GPM) 10 | No. of Stages | Setting Depth 40 FT. |
|----------------------------------|---------------|--------------------------------|

PUMP TEST

Well yielded _____ GPM with a drawdown of 25 ft. after _____ hours of pumping

WELL DATA

| | | |
|------------------------------|-----------------------------------|--|
| Well Depth 173 | Casing Diameter (In.) 4 | Casing Length (Ft.) 163 |
| Type of Casing PVC | Hole Depth 173 | Depth to Static Water Level 25 |

LOG DATA

TYPE OF LOG RUN (Circle One): No Log Run, Electric, Gamma Ray, Density, Sonic, Neutron, Other (Describe)

Name of Organization Running Log

TYPE OF COMPLETION: (Circle One or More):
Gravel Packed, Underreamed, Telescoped, Natural Development, Open Hole, Other (Describe)

GEOLOGIC DATA (Office Use Only)

| | | | |
|---------------|---------------|----------------|--------------|
| Surface Elev. | Geologic Unit | Unit Thickness | Depth to Top |
| Subs. SWL | Date | Analysis | Aquifer Test |

WELL GROUTED TO A DEPTH OF 3 FEET
Type Grout (circle one) Cement, Bentonite, or Mix

Driller's Remarks
IN A DEEP hollow

Top of Lap Pipe or Reduction in Casing

FEET IF TELESCOPED OR MORE THAN ONE SCREEN: USE BACK PAGE

SCREEN DATA

| | | |
|--------------------------------|--------------------------------------|-----------------------------------|
| Diameter - Inches 4 | Length - Feet 10 | Slot Size - Inches .013 |
| Screen Type PVC slot | Depth to Bottom - Feet 163 | |

| DESCRIPTION OF FORMATIONS ENCOUNTERED | FROM | TO |
|---------------------------------------|-----------|------------|
| Red + white clay + Sand | 0 | 5 |
| White clay + Sand Rock | 5 | 10 |
| Gray Clay | 10 | 95 |
| White Sand | 95 | 173 |
| | | |
| | | |
| | | |

FORMATIONS (Continued)

RECEIVED


OCT 12 1999

Dept. of Environmental Quality
Office of Land & Water Resources

IF MORE SPACE IS NEEDED, USE BACK

If well telescopes please
sketch and show depths.

GROUND LEVEL

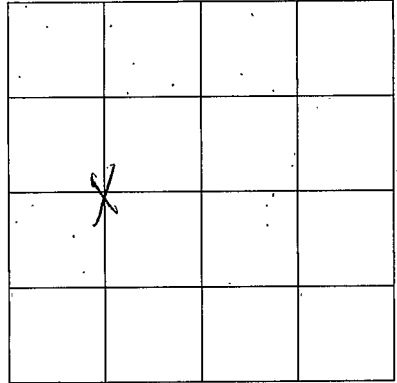

SECTION 26

Please indicate well location X.

ADDITIONAL INFORMATION

If more than one screen,
show location of each on sketch.