

Jate
F3
2-15-68

MISSISSIPPI
 BOARD OF WATER COMMISSIONERS
 416 North State Street
 Jackson, Mississippi 39201

CODED

WATER WELL DRILLERS LOG

2-15 1968 Harris Bros. Jate
 date well completed firm name county well located

LANDOWNER: Raymond Hensley
Rte. 2 Senatobia
 (mailing address)

description of formations encountered	from	to
top soil	0	25
red sand	25	40
gray clay	40	120
gray clay sand	120	145
white sand	145	174

WELL LOCATION:
 sec 3 | T 5 N R 8 E
9 miles W of Senatobia
 (distance) (direction) (nearest town)

WELL PURPOSE: home
 (home, irrigation, municipal, industrial)

WELL COMPLETION DATA:

(1) diameter (inches) 4

(2) total depth (feet) 174

(3) static water level (feet) 100 below top of ground.

(4) casing Plastic, 160
 (material) (depth)
4 if telescope see back.
 (size)

(5) screen 14 160
 (length) (depth to top)
008 Plastic
 (size) (material)

(6) pump 3/4 7
 (HP) (yield gpm)
elec.
 (type power)

(7) electric log no
 (yes or no)

(organization running log)

(8) how well bottom plugged back
shot

CODED


DEC 23 1968

DRILLERS REMARKS:

MISS. BD. OF
 WATER COM.

If well telescopes please sketch and show depths.

GROUND LEVEL

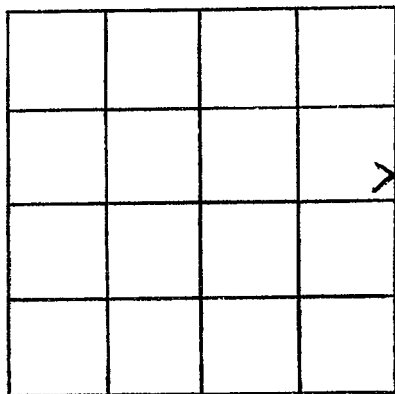

SECTION 31

Please indicate well location X.

ADDITIONAL INFORMATION

If more than one screen,
show locations of each on sketch.