

Late
74
9-22-68

MISSISSIPPI
BOARD OF WATER COMMISSIONERS
416 North State Street
Jackson, Mississippi 39201

CODED

WATER WELL DRILLERS LOG

Sept 22 1968 Shelby Keyman Late
date well completed firm name county well located

LANDOWNER: W.P. Keagy Jr.
Coldwater
Miss
(mailing address)

description of formations encountered	from	to
Red clay	0	20
Red Sand & Gravel	20	30

WELL LOCATION:
sec. 18 T 5 S R 8 E
4 miles N.W. of Senatobia
(distance) (direction) (nearest town)

white clay	30	40
grey clay	40	126

WELL PURPOSE: Home
(home, irrigation, municipal, industrial)

WELL COMPLETION DATA:
(1) diameter (inches) 2
(2) total depth (feet) 175
(3) static water level (feet) 80 below top of ground.
(4) casing Galvalume 168 (material) (depth)
(size) if telescope see back.
(5) screen 5ft (length) (depth to top)
1 1/4 Stainless Steel (size) (material)
(6) pump 1/2 (HP) 4 (yield gpm)
Electric (type power)
(7) electric log no (yes or no)
no (organization running log)
(8) how well bottom plugged Rubber Seal

SOLID ROCK	126	127 1/2
grey clay	127 1/2	160
white sand	160	175

DRILLERS REMARKS:


MISS. BD. OF
WATER COMM.

Rubber Seal OCT 16 1968

If well telescopes please sketch and show depths.

GROUND LEVEL

Well

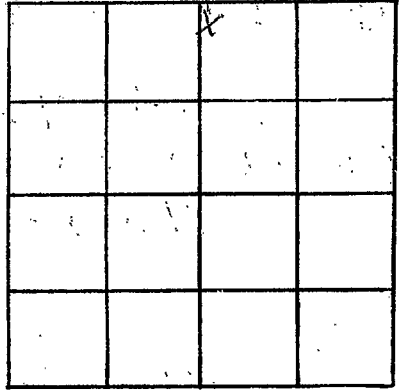

SECTION 18

Please indicate well location X.

ADDITIONAL INFORMATION

If more than one screen, show locations of each on sketch.