

TATE
76

WATER WELL DRILLERS LOG

(7) Date
June

Date: 10-5, 1961, Driller: JAC. R. Lipe (Name) County: Pontchartraine

10-5-61

(1) Owner of Land: Herman Robinson
(Name)
Senalobis, Miss
(Address)

(2) Location: 1/4, 1/4, Sec. 18, T. 5 R. 8 W. S. 1
9 miles N. West of Senalobis
(distance) (direction) (Nearest Town)

(3) Topography: flat
(Hilly) (Flat) (Level)

(4) Purpose of Well: Domestic
(Domestic Irrigation, Municipal, Industrial, Other)

Description & Color of Materials Sand, Clay, Red Clay, Shell, etc.	Thick- ness Feet	Depth Feet
Dark chert clay	0	50
white clay	50	70
fine sand	70	90
Black clay & sand	50	120
Loose silt & sand	120	147


Information upon completion of well:

- (1) Diameter 3 inches.
- (2) Total Depth 147 feet.
- (3) Water Level 20 feet below top of ground.
- (4) Cased to 100, Size 3"
- (5) Screen: Size 2", Length 5'
- (6) Were any formations sealed against pollution?
_____ yes, _____ no.

If YES depth of formation _____

Why _____

Drillers Remarks: _____

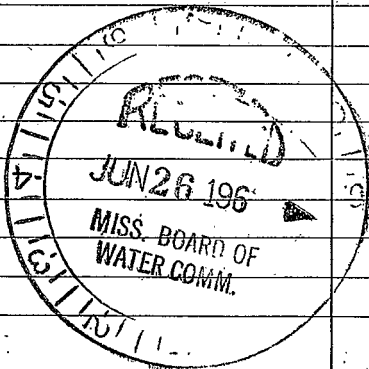

(Use Back Side)

Well No.

Retain this copy for your office files.

