

CODED

MISSISSIPPI  
BOARD OF WATER COMMISSIONERS  
416 North State Street  
Jackson, Mississippi 39201

WATER WELL DRILLERS LOG

TATE
R 7
7-18-69


July 19 1969 Shelby Newman Tate  
 Date well completed firm name county well located

LANDOWNER:	description of formations encountered	from	to
George F. Wayne Senobia, Miss. (mailing address)	Red clay	0	9.0
	Red sand & gravel	9.0	75
	white sand	75	98
WELL LOCATION: sec. 13 T. 5 S. R. 8 E. 3 miles N of Senobia (distance) (direction) (nearest town)			
WELL PURPOSE: (home, irrigation, municipal, industrial)			
WELL COMPLETION DATA:			
(1) diameter (inches) 2			
(2) total depth (feet) 90			
(3) static water level (feet) 70 below top of ground.			
(4) casing Galvanneal 84 (material) (depth)			
(size) If telescope see back.			
(5) screen 4 ft (length) (depth to top)			
1 1/2" Slanley Steel (size) (material)			
(6) pump 4-6 (HP) (yield gpm)			
Man Power (type power)			
(7) electric log (yes or no)			
(organization running log)			
(8) how well bottom plugged Reddy Seal			
DRILLERS REMARKS:			

AUG 27 1969  
 MISS. B.L. OR  
 EXHIBIT

If well telescopes please sketch and show depths.

GROUND LEVEL

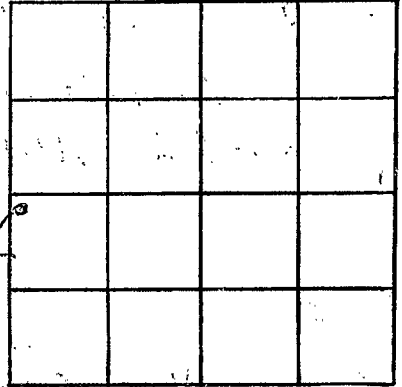

SECTION 13

Please indicate well location X.

ADDITIONAL INFORMATION

If more than one screen,  
show locations of each on sketch.