

CODED

MISSISSIPPI
BOARD OF WATER COMMISSIONERS
416 North State Street
Jackson, Mississippi 39201

WATER WELL DRILLERS LOG

TATE
E 8
7-24-69

July 24 1969 Shelly Newman Tate
date well completed firm name county well located

LANDOWNER:	description of formations encountered	from	to
James Merritt	Red clay	0	18
Coldwater Miss (mailing address)	gravel	18	22
	white clay	22	88
	white sand	88	100

WELL LOCATION: sec. 5 T 5 N R 8 E S W of Coldwater (distance) (direction) (nearest town)

WELL PURPOSE: home (home, irrigation, municipal, industrial)

WELL COMPLETION DATA:

- (1) diameter (inches) 2
- (2) total depth (feet) 100
- (3) static water level (feet) 82 below top of ground.
- (4) casing Galvump (material) (depth)
- (size) if telescope see back.
- (5) screen 5 (length) (depth to top) 1 1/2 Johnson Steel (size) (material)
- (6) pump 1/2 HP (type power) 4 (yield gpm)
- (7) electric log 40 (yes or no) Ams (organization running log)
- (8) how well bottom plugged Rubber Seal


DRILLERS REMARKS:

AUG 27 1969

Miss. Bd. of Water Comm.

If well telescopes please sketch and show depths.

GROUND LEVEL

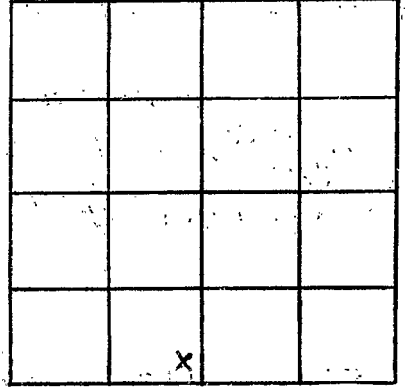

SECTION

Please indicate well location X.

ADDITIONAL INFORMATION

If more than one screen, show locations of each on sketch.