

Late
79
8-28-69

MISSISSIPPI
BOARD OF WATER COMMISSIONERS
416 North State Street
Jackson, Mississippi 39201

CODED

WATER WELL DRILLERS LOG


Aug 28 1969 Shell Newman Late
date well completed firm name county well located

LANDOWNER:	description of formations encountered	from	to
W. B. G. Giesel R. F. D. - 1		Red Clay	0
Coldwater, Miss. (mailing address)	gravel & sand	2.5	7.0
WELL LOCATION:	white sand	7.0	8.0
sec. 6 T 5 N R 8 E S 3/2 miles SE of Arab, La.			
WELL PURPOSE: Home (home, irrigation, municipal, industrial)			
WELL COMPLETION DATA:			
(1) diameter (inches) 2			
(2) total depth (feet) 85			
(3) static water level (feet) 70 below top of ground.			
(4) casing Galv. 74 (material) (depth)			
(size) if telescope see back.			
(5) screen 5 ft (length) (depth to top)			
1 1/2" slot (size) (material)			
(6) pump 3/4" 4 (HP) (yield gpm)			
Electric (type power)			
(7) electric log No (yes or no)			
(organization running log)			
(8) how well bottom plugged Rubber Seal			
DRILLERS REMARKS:			

SEP 25 1969
MISS. Bd. OE
WATER COMMISSIONERS

If well telescopes please sketch and show depths.

GROUND LEVEL

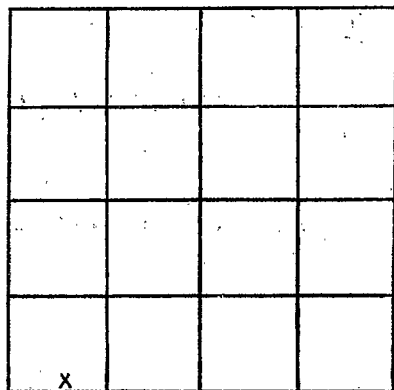

SECTION 6

Please indicate well location X.

ADDITIONAL INFORMATION

If more than one screen, show locations of each on sketch.