

TATE
R 10
- 69

MISSISSIPPI
BOARD OF WATER COMMISSIONERS
416 North State Street
Jackson, Mississippi 39201

CODED

WATER WELL DRILLERS LOG

date well completed

1969 *Shelly Newman*
firm name

county well located

Tate

LANDOWNER:

R. T. Vespey
Senobia Miss

description of formations
encountered

grey clay
white sand

from

to

0 *40*

40 *50*

(mailing address)

WELL LOCATION:

sec. *15* T. *5* N

R. *3* E

5 miles *SW* of *Senobia*
(distance) (direction) (nearest town)

WELL PURPOSE:

(home, irrigation, municipal, industrial)

Home

WELL COMPLETION DATA:

- (1) diameter (inches) *2*
(2) total depth (feet) *50*
(3) static water level (feet) *38* below
top of ground. ~~above~~
(4) casing *Galv* *4 2*
(material) (depth)

(size) If telescope see back.

- (5) screen *4 ft* (length) (depth to top)
1/2 (size) *Slotted Steel* (material)
(6) pump *Hand* *4-6* (HP) (yield gpm)
Man Power (type power)

- (7) electric log *no*
(yes or no)

JW
(organization running log)

- (8) how well bottom plugged *Partially*


DRILLERS REMARKS:

MISSISSIPPI BOARD OF WATER COMMISSIONERS

MISS. BO. OF WATER COMMISSIONERS

If well telescopes please sketch and show depths.

GROUND LEVEL

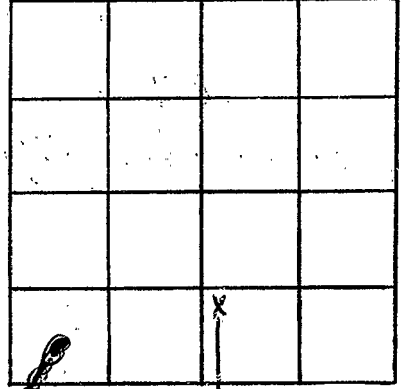

well

WELL SECTION 10

Please indicate well location X.

ADDITIONAL INFORMATION

If more than one screen, show locations of each on sketch.