

TATE
F 11
4-1-69

MISSISSIPPI
BOARD OF WATER COMMISSIONERS
416 North State Street
Jackson, Mississippi 39201

CODED

WATER WELL DRILLERS LOG

4-1 1969 Harris Bros. Tate
date well completed firm name county well located

LANDOWNER: Z.M. Kenzly
Coldwater
(mailing address)

description of formations encountered	from	to
top soil	0	20
red sand & gravel	20	35
sand & clay	35	80
fine sand	80	95
coarse sand	95	130

WELL LOCATION:
sec. 2 T 5 N R 8 E
4 miles W of Coldwater
(distance) (direction) (nearest town)

WELL PURPOSE: Municipal
(home, irrigation, municipal, industrial)


- WELL COMPLETION DATA:
- (1) diameter (inches) 4"
 - (2) total depth (feet) 130
 - (3) static water level (feet) 80 ^{below}/_{above} top of ground.
 - (4) casing Plastic ~~116~~
(material) (depth)
4" If telescope see back.
(size)
 - (5) screen 14' 116
(length) (depth to top)
008 Plastic
(size) (material)
 - (6) pump 1/2 25
(HP) (yield gpm)
elec.
(type power)
 - (7) electric log no
(yes or no)
 - (organization running log)
 - (8) how well bottom plugged track
shot

DRILLERS REMARKS:

DEC 29 1969
MISS. DE. OF
WATER CONTROL

If well telescopes please sketch and show depths.

GROUND LEVEL

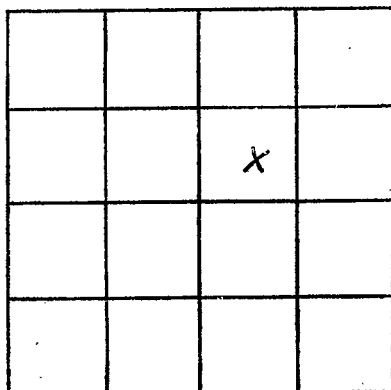

SECTION 2

Please indicate well location X.

ADDITIONAL INFORMATION

If more than one screen, show locations of each on sketch.