

CODED

MISSISSIPPI
BOARD OF WATER COMMISSIONERS
416 North State Street
Jackson, Mississippi 39201

WATER WELL DRILLERS LOG

TATE
R 12
8-25-69

8-25 date well completed 169 Harris Bros. firm name Tate county well located

LANDOWNER: ~~John~~
Lomas Wilburn
P.O. 1 Senatobia
(mailing address)

description of formations encountered	from	to
top soil	0	20
pingrauel + sand	20	65
fine sand	65	115
Coarse sand	115	130

WELL LOCATION:
sec. 13 T 5 N R 8 E
2 miles NW of Senatobia
(distance) (direction) (nearest town)

WELL PURPOSE: none
(home, irrigation, municipal, industrial)

WELL COMPLETION DATA:

(1) diameter (inches) 4"

(2) total depth (feet) 130'

(3) static water level (feet) 60' ^{below} top of ground.

(4) casing Plastic, 123' (material) (depth)
4" (size) if telescope see back.

(5) screen 7' 123' (length) (depth to top)
008 Plastic (size) (material)

(6) pump 3/4 10 (HP) (yield gpm)
elec. (type power)

(7) electric log no (yes or no)
(organization running log)

(8) how well bottom plugged back shot


DEC 29 1969

MISS. BD. OF
WATER COMM.

DRILLERS REMARKS:

If well telescopes please sketch and show depths.

GROUND LEVEL

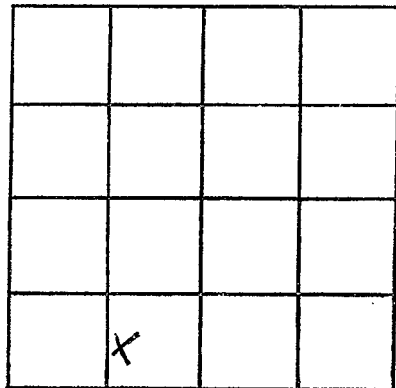

SECTION 13

Please indicate well location X.

ADDITIONAL INFORMATION

If more than one screen, show locations of each on sketch.