

Tate
F 19
5-5-70

MISSISSIPPI
BOARD OF WATER COMMISSIONERS
416 North State Street
Jackson, Mississippi 39201

CODED

WATER WELL DRILLERS LOG

5-5-70 19 Jim Renix Tate
date well completed firm name county well located

LANDOWNER: Essec Bolton
Rt. 1
Coldwater, Miss.
(mailing address)

description of formations encountered	from	to
Dirt	0	20
Sand & Gravel	20	120
###	120	149
Sand	120	149

WELL LOCATION:
sec. 4 T. 5 R. 8
3 miles West of Coldwater
(distance) (direction) (nearest town)

WELL PURPOSE: Home
(home, irrigation, municipal, industrial)

WELL COMPLETION DATA:

- (1) diameter (inches) 2
- (2) total depth (feet) 149
- (3) static water level (feet) 45 below top of ground. ~~###~~
- (4) casing 2 & 1 1/4 Galv. (material) 145 (depth)
2 & 1 1/4 If telescope see back. (size)
- (5) screen 48 in. (length) 145 (depth to top)
1 1/4 (size) Brass (material)
- (6) pump 1/2 (HP) 3 (yield gpm)
- (7) electric log no (yes or no)
(organization running log)
- (8) how well bottom plugged open

CODED


JUN 19 1970

MISS. Bd. OF WATER COMM.

DRILLERS REMARKS:

If well telescopes please sketch and show depths.

GROUND LEVEL

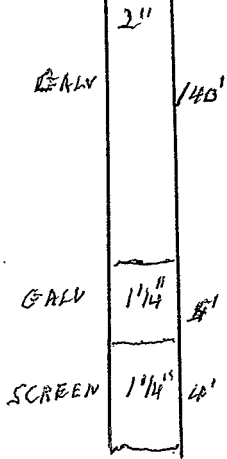

		X	

SECTION 17

Please indicate well location X.

ADDITIONAL INFORMATION

If more than one screen, show locations of each on sketch.