

TATE
F 18
3-29-71

MISSISSIPPI
BOARD OF WATER COMMISSIONERS
416 North State Street
Jackson, Mississippi 39201

CODED

WATER WELL DRILLERS LOG

3-29 date well completed 19 71 Harris Bros. firm name Tate county well located

LANDOWNER: Mildred Hassell
pt. 1
Caldwater
(mailing address)

WELL LOCATION:
sec. 2 T S N R 8 E
2 1/2 miles SW of Caldwater
(distance) (direction) (nearest town)

description of formations encountered	from	to
<u>top soil</u>	<u>0</u>	<u>20</u>
<u>grey clay</u>	<u>20</u>	<u>105</u>
<u>fine sand + clay</u>	<u>105</u>	<u>185</u>
<u>coarse sand</u>	<u>185</u>	<u>210</u>

WELL PURPOSE: home
(home, irrigation, municipal, industrial)

- WELL COMPLETION DATA:
- (1) diameter (inches) 4
 - (2) total depth (feet) 210
 - (3) static water level (feet) 120 ^(below) _(above) top of ground.
 - (4) casing Plastic, 196
(material) (depth)
 - 4 if telescope see back.
(size)
 - (5) screen 14, 196
(length) (depth to top)
 - 008, Plastic
(size) (material)
 - (6) pump 3/4, 7
(HP) (yield gpm)
 - elec.
(type power)
 - (7) electric log no
(yes or no)

CODED

(organization running log)

(8) how well bottom plugged back
shot


MAY 14 1971

MISS. BD. OF
WATER COMMISSIONERS

DRILLERS REMARKS:

If well telescopes please sketch and show depths.

GROUND LEVEL

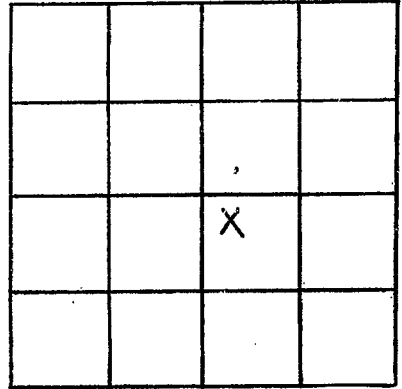

SECTION 2

Please indicate well location X.

ADDITIONAL INFORMATION

If more than one screen, show locations of each on sketch.