

TATE  
F21  
9-2-71

MISSISSIPPI  
BOARD OF WATER COMMISSIONERS DEC 8 1971  
416 North State Street  
Jackson, Mississippi 39201

WATER WELL DRILLERS LOG

MISS. Bd. OF  
**CODED**


9-2 71 Harris Bros. Tate  
date well completed firm name county well located

LANDOWNER: <i>Smally Jolivar</i>	description of formations encountered	from	to
<i>Rt. 1</i> <i>Coldwater</i> (mailing address)			
WELL LOCATION: sec. <i>2</i> T <i>5</i> N R <i>8</i> E <i>1 1/2</i> miles <i>W</i> <i>Coldwater</i> (distance) (direction) (nearest town)	<i>top soil</i>	<i>0</i>	<i>20</i>
WELL PURPOSE: <i>none</i> (home, irrigation, municipal, industrial)	<i>gravel</i>	<i>20</i>	<i>35</i>
WELL COMPLETION DATA: (1) diameter (inches) <i>4</i>	<i>gray clay</i>	<i>35</i>	<i>140</i>
(2) total depth (feet) <i>210</i>	<i>sand + clay</i>	<i>140</i>	<i>185</i>
(3) static water level (feet) <i>80</i> <sup>below</sup> <sub>above</sub> top of ground.	<i>coarse sand</i>	<i>185</i>	<i>210</i>
(4) casing <i>plastic</i> , <i>196</i> (material) (depth)			
<i>4</i> (size) if telescope see back.			
(5) screen <i>14</i> , <i>196</i> (length) (depth to top)			
<i>008</i> , <i>plastic</i> (size) (material)			
(6) pump <i>3/4</i> , <i>7</i> (HP) (yield gpm)			
<i>elec</i> (type power)			
(7) electric log <i>no</i> (yes or no)			
(organization running log)			
(8) how well bottom plugged <i>back</i> <i>is not</i>			
DRILLERS REMARKS:			

**CODED**

If well telescopes please sketch and show depths.

GROUND LEVEL

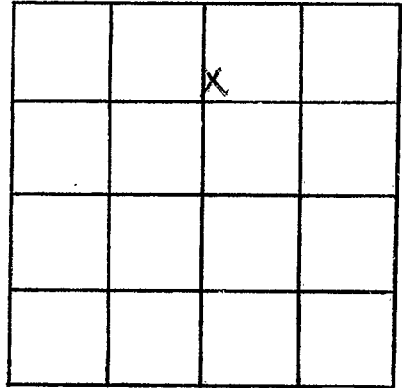

SECTION 2

Please indicate well location X.

ADDITIONAL INFORMATION

If more than one screen,  
show locations of each on sketch.