

TATE
F22
Elog #14
Feb 10
~~March 18~~

MISSISSIPPI
BOARD OF WATER COMMISSIONERS
416 North State Street
Jackson, Mississippi 39201

1

CODED

WATER WELL DRILLERS LOG

1972 LIPE WELL CO.

TATE

date well completed

firm name

county well located

LANDOWNER:	description of formations encountered	from	to
City of Senatobia	top soil	0	24
	sand & gravel	24	47
	sand & gumbo	47	68
	sand (white)	68	91
	sand	91	115
	sand	115	138
	sand	138	161
	sand & shale	161	184
	sand	184	206
	sand	206	227
	sand	227	249
	shale	249	254
	lignite	254	271
	lignite (porous)	271	293
	gumbo	293	317
	sandy gumbo	317	340
	shale	340	362
	shale	362	385
	sand (white)	385	409
	sand	409	432
	sand	432	452
	sand	452	472
	sand	472	492
	sand	492	512
	sandy gumbo	512	532
	sandy gumbo	532	552
	sand (white)	552	572
	sand	572	592
	sand	592	612
	sand	612	632
	sand	632	652
	sand	652	672
	sand	672	692
	sand	692	712
	sand	712	732
	sand	732	752
	sandy shale	752	772
	sand & shale	772	792
	sand	792	812
	sand	812	832

(mailing address)

WELL LOCATION:

sec. 25 T 5 N R 8 E
S W
1 miles W of Senatobia
(distance) (direction) (nearest town)

WELL PURPOSE: municipal test
(home, irrigation, municipal, industrial)


WELL COMPLETION DATA:

- (1) diameter (inches) 8"
- (2) total depth (feet) 1242
- (3) static water level (feet) 47' below top of ground.
- (4) casing steel, 1065 (material) (depth)
4" (size) if telescope see back.
- (5) screen 20', 1065 (length) (depth to top)
4" (size) SS (material)
- (6) pump (HP) (yield gpm)
(type power)
- (7) electric log yes (yes or no)
USGS (organization running log)
- (8) how well bottom plugged steel plug

DRILLERS REMARKS:

If well telescopes please sketch and show depths.

GROUND LEVEL

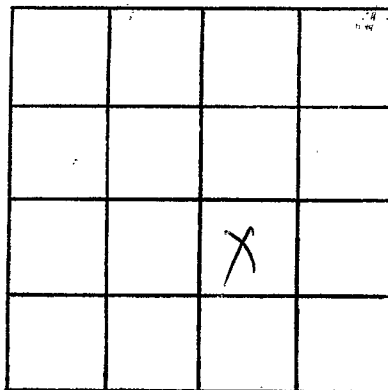

SECTION 25

Please indicate well location X.

ADDITIONAL INFORMATION

If more than one screen, show locations of each on sketch.