

**TATE**  
**F 23**  
**7-11-72**

MISSISSIPPI  
 BOARD OF WATER COMMISSIONERS  
 416 North State Street  
 Jackson, Mississippi 39201


WATER WELL DRILLERS LOG

7/11/72 19 Hicks Brothers Well Co. Tate  
 date well completed firm name county well located

LANDOWNER: <u>Jim Mc Donald</u> <u>Rt. II Senatobia, Miss.</u>	description of formations encountered	from	to
(mailing address)	<u>Red clay</u>	<u>0</u>	<u>45</u>
WELL LOCATION: sec. <u>30</u> T. <u>5</u> N. R. <u>8</u> E <u>1</u> miles <u>West</u> of <u>Senatobia</u> (distance) (direction) (nearest town)	<u>Red Sand &amp; gravel</u>	<u>45</u>	<u>75</u>
WELL PURPOSE: <u>Home</u> (home, irrigation, municipal, industrial)	<u>Black clay</u>	<u>75</u>	<u>165</u>
WELL COMPLETION DATA:	<u>White Sand</u>	<u>165</u>	<u>245</u>
(1) diameter (inches) <u>4</u>			
(2) total depth (feet) <u>245</u>			
(3) static water level (feet) <u>83</u> below above top of ground.			
(4) casing <u>Plastic</u> <u>240</u> (material) (depth)			
(5) screen <u>5ft.</u> <u>5ft.</u> (length) (depth to top)			
(6) pump <u>3/4</u> <u>10</u> (HP) (yield gpm)			
(7) electric log <u>220</u> (type power)			
(8) how well bottom plugged <u>Cap</u>			
DRILLERS REMARKS:	<u>JUL 17 1972</u>		

If well telescopes please sketch and show depths.

GROUND LEVEL

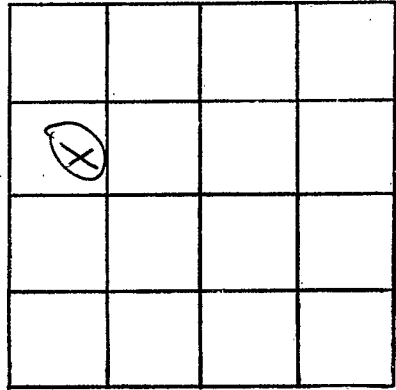

SECTION \_\_\_\_\_

Please indicate well location X.

ADDITIONAL INFORMATION

If more than one screen,  
show locations of each on sketch.