

TATE
F 24
7-20-72

MISSISSIPPI
BOARD OF WATER COMMISSIONERS
416 North State Street
Jackson, Mississippi 39201

CODED

WATER WELL DRILLERS LOG

7-20-1972 Hicks Bros. Well Co. Late
date well completed firm name county well located

LANDOWNER: <u>J. K. Cahill</u>	description of formations encountered	from	to
<u>2 1/2 Tr. Ranch</u>	<u>Red Clay & Gravel</u>	<u>0</u>	<u>30</u>
<u>Senatobia, Miss.</u> (mailing address)	<u>Gravel & Sand</u>	<u>30</u>	<u>45</u>
WELL LOCATION:	<u>Black Clay</u>	<u>45</u>	<u>135</u>
sec <u>20 T 5 N R 8 E</u> <u>5</u> miles <u>West</u> of <u>Senatobia</u> (distance) (direction) (nearest town)	<u>White Sand</u>	<u>135</u>	<u>165</u>
WELL PURPOSE: <u>Stone</u> (home, irrigation, municipal, industrial)			
WELL COMPLETION DATA:			
(1) diameter (inches) <u>4 inches</u>			
(2) total depth (feet) <u>165</u>			
(3) static water level (feet) <u>65 ft</u> below top of ground.			
(4) casing <u>Plastic, 165</u> (material) (depth)			
_____ If telescope see back: (size)			
(5) screen <u>10 ft, 10 ft</u> (length) (depth to top)			
<u>4 in, Slotted</u> (size) (material)			
(6) pump <u>3/4 10 GPM</u> (HP) (yield gpm)			
<u>Electric</u> (type power)			
(7) electric log <u>No</u> (yes or no)			
_____ (organization running log)			
(8) how well bottom plugged <u>Cap</u>			
DRILLERS REMARKS:			


CODED

JUL 27 1972

MISS. BU. OF WATER COMMISSIONERS

If well telescopes please sketch and show depths.

GROUND LEVEL

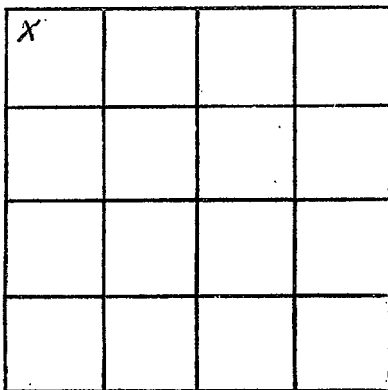

SECTION 20

Please indicate well location X.

ADDITIONAL INFORMATION

If more than one screen, show locations of each on sketch.