

TATE
F 26
9-1-72

MISSISSIPPI
BOARD OF WATER COMMISSIONERS
416 North State Street
Jackson, Mississippi 39201

CODED

WATER WELL DRILLERS LOG

9-1-1972 Bob Smith Tate
date well completed firm name county well located


LANDOWNER:	description of formations encountered	from	to
J. F. Allen	clay dirt		8
Coldwater - Miss. (mailing address)	gravel	8	20
WELL LOCATION: sec. 4 T 5 N R 8 E (S) (W)	gumbo	20	100
3 miles east of Coldwater (distance) (direction) (nearest town)	white sand	100	163
WELL PURPOSE: Home (home, irrigation, municipal, industrial)			
WELL COMPLETION DATA:			
(1) diameter (inches) 4			
(2) total depth (feet) 163			
(3) static water level (feet) 100 below top of ground.			
(4) casing Plastic 163 (material) (depth)			
(size) if telescope see back.			
(5) screen 20 143 (length) (depth to top)			
4 Plastic (size) (material)			
(6) pump 3/4 15 (HP) (yield gpm)			
Elec (type power)			
(7) electric log no (yes or no)			
(organization running log)			
(8) how well bottom plugged Plugged			
DRILLERS REMARKS:			

CODED

FEB 22 1973

If well telescopes please sketch and show depths.

GROUND LEVEL

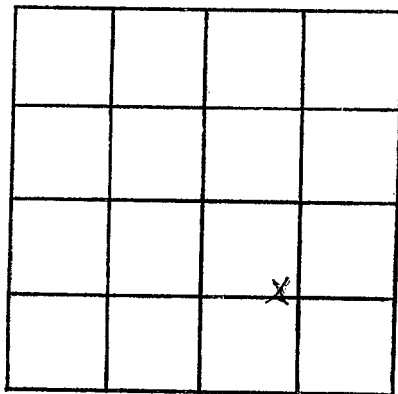

SECTION 4

Please indicate well location X.

ADDITIONAL INFORMATION

Thin Rocks at 45 & 55

If more than one screen, show locations of each on sketch.