

MISSISSIPPI
BOARD OF WATER COMMISSIONERS
416 North State Street
Jackson, Mississippi 39201

CODED

WATER WELL DRILLERS LOG

TATE
F 28
12-1-72

12-1
date well completed

1972 Harris Bros.
firm name

Tate
county well located

LANDOWNER: Antioch Church

Pt. 2

Senatobia
(mailing address)

WELL LOCATION:

sec. 14 T. S N. R. 8 E. W.
3 miles NW of Senatobia
(distance) (direction) (nearest town)

WELL PURPOSE: Church
(home, irrigation, municipal, industrial)

WELL COMPLETION DATA:

- (1) diameter (inches) 4
- (2) total depth (feet) 150
- (3) static water level (feet) 100 below above top of ground.
- (4) casing Plastic, 136
(material) (depth)
4 if telescope see back.
(size)
- (5) screen 14, 136
(length) (depth to top)
008 Plastic
(size) (material)
- (6) pump 3/4, 7
(HP) (yield gpm)
elec.
(type power)
- (7) electric log no
(yes or no)
- (organization running log)
- (8) how well bottom plugged solid

description of formations encountered

from to

<u>top soil</u>	<u>0</u>	<u>15</u>
<u>red sand</u>	<u>15</u>	<u>30</u>
<u>gray clay</u>	<u>30</u>	<u>75</u>
<u>fine sand</u>	<u>75</u>	<u>125</u>
<u>coarse sand</u>	<u>125</u>	<u>150</u>


CODED

DRILLERS REMARKS:

MISS. BD. OF
WATER COMM

If well telescopes please sketch and show depths.

GROUND LEVEL

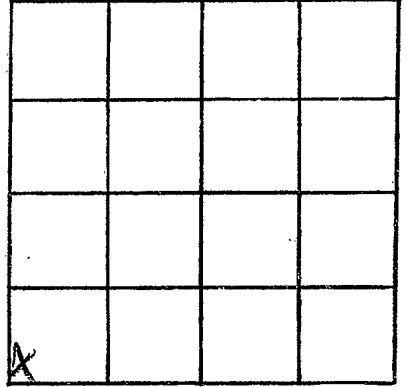

SECTION 14

Please indicate well location X.

ADDITIONAL INFORMATION

If more than one screen, show locations of each on sketch.