

MISSISSIPPI
BOARD OF WATER COMMISSIONERS
416 North State Street
Jackson, Mississippi 39201

CODED

WATER WELL DRILLERS LOG


TATE
F 29
1-10-73

1-10-1973 date well completed *Bob Smith* firm name *Jete* county well located

LANDOWNER:	description of formations encountered	from	to
<i>Paradise Baptist Church</i>			
<i>Senatobia, Miss.</i> (mailing address)	<i>Thin sandrock</i>	<i>at</i>	<i>8</i>
WELL LOCATION:	<i>Clay</i>	<i>8</i>	<i>15</i>
sec. <i>36</i> T. <i>5</i> N. R. <i>8</i> E.	<i>gravel</i>	<i>15</i>	<i>35</i>
<i>2 1/4</i> miles <i>SW</i> of <i>Senatobia</i>	<i>white clay</i>	<i>35</i>	<i>40</i>
(distance) - (direction) of (nearest town)	<i>Red sand + gravel</i>	<i>40</i>	<i>65</i>
WELL PURPOSE: <i>Drinking</i> (home, irrigation, municipal, industrial)	<i>white clay</i>	<i>65</i>	<i>68</i>
WELL COMPLETION DATA:	<i>white sand</i>	<i>68</i>	<i>140</i>
(1) diameter (inches) <i>4</i>			
(2) total depth (feet) <i>140</i>			
(3) static water level (feet) <i>57</i> below top of ground.			
(4) casing <i>Plastic</i> , <i>140</i> (material) (depth)			
(size) if telescope see back.			
(5) screen <i>20</i> , <i>120</i> (length) (depth to top)			
<i>4</i> , <i>Plastic</i> (size) (material)			
(6) pump <i>1/3</i> , <i>10</i> (HP) (yield gpm)			
<i>Elec.</i> (type power)			
(7) electric log <i>no</i> (yes or no)			
(organization running log)			
(8) how well bottom plugged <i>plugged</i>			
DRILLERS REMARKS:			

If well telescopes please sketch and show depths.

GROUND LEVEL

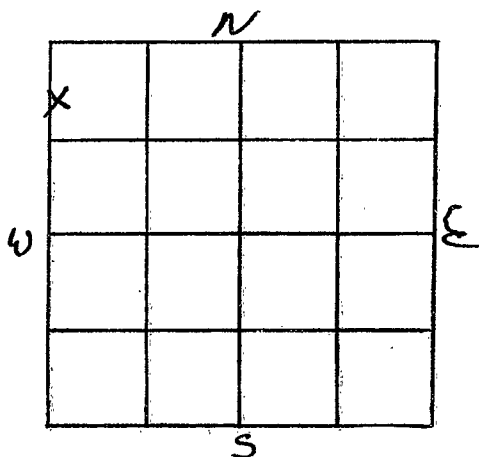

SECTION 3C

Please indicate well location X.

ADDITIONAL INFORMATION

If more than one screen, show locations of each on sketch.