

LATE
F 32
11-1-73

MISSISSIPPI
BOARD OF WATER COMMISSIONERS
416 North State Street
Jackson, Mississippi 39201

WATER WELL DRILLERS LOG

CODED

11-1 1973 Harris Bros. county well located

LANDOWNER: Gerald Conley
Rt. 1
Coldwater
(mailing address)


description of formations encountered	from	to
<u>top soil</u>	<u>0</u>	<u>15</u>
<u>clay + sand</u>	<u>15</u>	<u>85</u>
<u>Coarse sand</u>	<u>85</u>	<u>100</u>

WELL LOCATION:
sec. 2 T 5 N R 8 E
1 1/2 miles W of Coldwater
(distance) (direction) (nearest town)

WELL PURPOSE: None
(home, irrigation, municipal, industrial)

- WELL COMPLETION DATA:
- (1) diameter (inches) 4
 - (2) total depth (feet) 100
 - (3) static water level (feet) 60 below above top of ground.
 - (4) casing Plastic, 93
(material) (depth)
4 If telescope see back.
(size)
 - (5) screen 7, 93
(length) (depth to top)
008, Plastic
(size) (material)
 - (6) pump 3/4, 7
(HP) (yield gpm)
elec.
(type power)
 - (7) electric log No
(yes or no)
- (organization running log)
- (8) how well bottom plugged solid

CODED

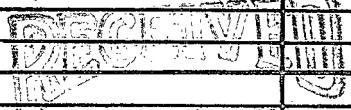

FEB 22 1974

DRILLERS REMARKS:

If well telescopes please sketch and show depths.

GROUND LEVEL

	X		

SECTION 12

Please indicate well location X.

ADDITIONAL INFORMATION

If more than one screen, show locations of each on sketch.