

TATE
F 35
4-3-79

MISSISSIPPI
BOARD OF WATER COMMISSIONERS
416 North State Street
Jackson, Mississippi 39201

WATER WELL DRILLERS LOG

CODED

4-3-79 date well completed
 24 Hicks Exp. Well Co. firm name
 State county well located

LANDOWNER:
 Ken Smith -
 Senatobia, Miss
 (mailing address)

description of formations encountered	from	to
Red Clay	0	15
White Clay & Gravel	15	45
Black Clay	45	90
White Sand	90	125

WELL LOCATION:
 sec. 13 T. 5 N. R. 8 E.
 3 miles NE of Senatobia
 (distance) (direction) (nearest town)

WELL PURPOSE: Water
 (home, irrigation, municipal, industrial)

WELL COMPLETION DATA:

(1) diameter (inches) 4 in.

(2) total depth (feet) 125

(3) static water level (feet) 50 (below/above top of ground)

(4) casing Plastic, 125,
 (material) (depth)
 (size) if telescope see back.

(5) screen 4 ft, 121
 (length) (depth to top)
4 in., Gravel
 (size) (material)

(6) pump 1/2, 3
 (HP) (yield gpm)
Electric 220
 (type power)


(7) electric log NO
 (yes or no)

(organization running log)

(8) how well bottom plugged Cap

CODED

DRILLERS REMARKS:

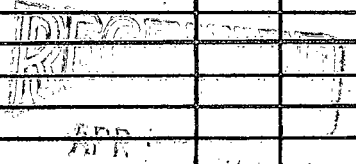

If well telescopes please sketch and show depths.

GROUND LEVEL

*			

SECTION 13

Please indicate well location X.

ADDITIONAL INFORMATION

If more than one screen,
show locations of each on sketch.