

TATE  
F 36  
3-26-74

MISSISSIPPI  
BOARD OF WATER COMMISSIONERS  
416 North State Street  
Jackson, Mississippi 39201

WATER WELL DRILLERS LOG

CODED

3-26-74 date well completed      74 Bluffs Dr. W. firm name      Tate county well located

LANDOWNER:  
Honey Lyle - Rt 2  
Box 199A, Holly Springs  
(mailing address)

description of formations encountered	from	to
Red Clay	0	15
Gravel	15	120
Black Clay	120	135
White Sand & Black Clay	135	150
White Sand	150	198

WELL LOCATION:  
see 35 T 5 N R 8 E  
2 1/2 miles W of Senatobia  
(distance) (direction) (nearest town)

WELL PURPOSE: Home  
(home, irrigation, municipal, industrial)

WELL COMPLETION DATA:

(1) diameter (inches) 4 1/2 in.

(2) total depth (feet) 198

(3) static water level (feet) 100 below above top of ground.

(4) casing Plastic, 198, (material) (depth)

(size) if telescope see back.

(5) screen 14, 184 (length) (depth to top)  
4 1/2 in. Inside Gravel (size) (material)

(6) pump 3/4, 10 (HP) (yield gpm)  
Electric 220 (type power)

(7) electric log 90 (yes or no)

(organization running log)


(8) how well bottom plugged Cop

CODED

DRILLERS REMARKS:

If well telescopes please sketch and show depths.

GROUND LEVEL

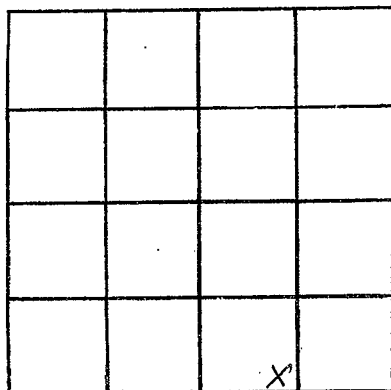

SECTION 35

Please indicate well location X.

ADDITIONAL INFORMATION

If more than one screen,  
show locations of each on sketch.