

TATE  
F37  
4-11-74

MISSISSIPPI  
BOARD OF WATER COMMISSIONERS  
416 North State Street  
Jackson, Mississippi 39201

WATER WELL DRILLERS LOG

4-11-74 date well completed  
 J. H. Links Co. firm name  
 Tate county well located

LANDOWNER:  
 James Mayfield - Pt 2  
 Senatobia, Miss  
 (mailing address) 38668

description of formations encountered  
 from to

WELL LOCATION:  
 sec 27 5 N R 8 E  
 2 1/2 miles W of Senatobia

WELL PURPOSE: Home  
 (home, irrigation, municipal, industrial)


- WELL COMPLETION DATA:
- (1) diameter (inches) 4 in
  - (2) total depth (feet) 160
  - (3) static water level (feet) 50 <sup>below</sup> top of ground
  - (4) casing Electric, 160,  
 (material) (depth)
  - (size) if telescope see back.
  - (5) screen 12 ft, 148  
 (length) (depth to top)  
4 in, Brass  
 (size) (material)
  - (6) pump 1 1/2 20  
 (HP) (yield gpm)  
Electric 220  
 (type power)
  - (7) electric log NO  
 (yes or no)
  - (organization running log)
  - (8) how well bottom plugged Cap

DRILLERS REMARKS:

APR 25 1974  
 MISS. BB. OF WATER COMMISSIONERS

If well telescopes please sketch and show depths.

GROUND LEVEL

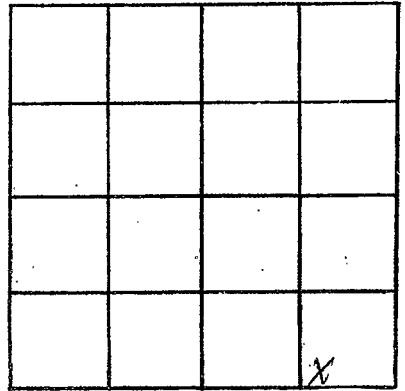

SECTION 27

Please indicate well location X.

ADDITIONAL INFORMATION

If more than one screen,  
show locations of each on sketch.