

TATE
F39
5-6-74

MISSISSIPPI
BOARD OF WATER COMMISSIONERS
416 North State Street
Jackson, Mississippi 39201

CODED

WATER WELL DRILLERS LOG

5-6 1974 Bob Smith & Son Tate
date well completed firm name county well located

LANDOWNER: J.P. Wilson
Domeaway, Inc.
Senatchia, Miss.
(mailing address)

description of formations encountered	from	to
Top soil	0'	5'
Red clay	5'	60'
Fine sand and clay	60'	100'
Sand	100'	166'


WELL LOCATION:
sec. 25 T 5 N R 8 E
1 miles West of Senatchia
(distance) (direction) (nearest town)

WELL PURPOSE: Home
(home, irrigation, municipal, industrial)

- WELL COMPLETION DATA:
- (1) diameter (inches) 4
 - (2) total depth (feet) 166
 - (3) static water level (feet) 96 below top of ground.
 - (4) casing Plastic, 166.
(material) (depth)
 - (size) if telescope see back.
 - (5) screen 10, 156
(length) (depth to top)
 - 4, Plastic
(size) (material)
 - (6) pump 1/2, 10
(HP) (yield gpm)
 - Electric
(type power)
 - (7) electric log no
(yes or no)
 - (organization running log)
 - (8) how well bottom plugged plugged

CODED


DRILLERS REMARKS:

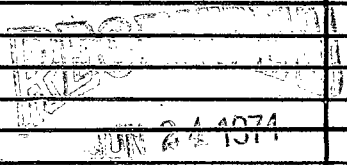

MISS. BD. OF WATER COMMISSIONERS

If well telescopes please sketch and show depths.

GROUND LEVEL

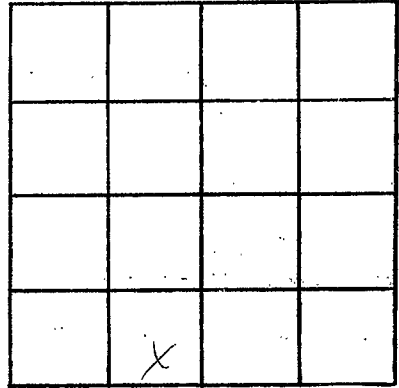

SECTION 25

Please indicate well location X.

ADDITIONAL INFORMATION

If more than one screen, show locations of each on sketch.