

TATE
F40
8-6-73

MISSISSIPPI
BOARD OF WATER COMMISSIONERS
416 North State Street
Jackson, Mississippi 39201

WATER WELL DRILLERS LOG **CODED**

8-6-1973
date well completed

Sub Soil
firm name

Jate
county well located

LANDOWNER:

Jessie B. Lee

Caldwater - Miss.
(mailing address)

description of formations encountered

Top soil

from

to

0' 5'

Red clay

5' 40'

Sand

40' 120'

WELL LOCATION:

sec. 2 T 5 N R 8 E
(S) (W)
2 miles W of Caldwater
(distance) (direction) (nearest town)

WELL PURPOSE: None
(home, irrigation, municipal, industrial)

WELL COMPLETION DATA:

- (1) diameter (inches) 4
(2) total depth (feet) 120
(3) static water level (feet) 62 below above top of ground.
(4) casing Plastic, 120 (material) (depth)

(size) if telescope see back.

- (5) screen 20 100 (length) (depth to top)
4 Plastic (size) (material)

- (6) pump 1/3 10 (HP) (yield gpm)

E Lee (type power)

- (7) electric log no (yes or no)

(organization running log)

- (8) how well bottom plugged plugged


DRILLERS REMARKS:

CODED

JUN 24 1974

If well telescopes please sketch and show depths.

GROUND LEVEL

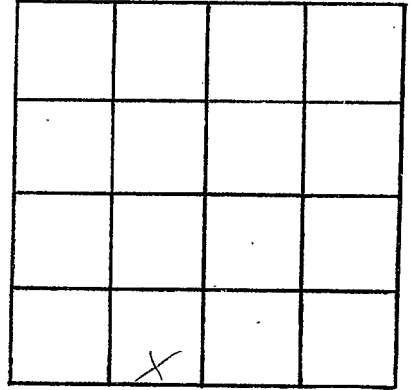

SECTION 2

Please indicate well location X.

ADDITIONAL INFORMATION

If more than one screen,
show locations of each on sketch.