

TATE
FAZ
3-27-74

MISSISSIPPI
 BOARD OF WATER COMMISSIONERS
 416 North State Street
 Jackson, Mississippi 39201


CODED

WATER WELL DRILLERS LOG

3-27 1974 Bob Smith Tate
 date well completed firm name county well located

LANDOWNER:	description of formations encountered	from	to
<u>Hugh Wright</u>			
<u>Coldwater, Miss</u> (mailing address)	<u>Red clay</u>	<u>5'</u>	<u>20'</u>
WELL LOCATION:	<u>Sand</u>	<u>20'</u>	<u>130'</u>
sec. <u>4</u> T. <u>X</u> N. R. <u>8</u> E. <u>2 1/2</u> miles <u>SW</u> of <u>Coldwater</u> (distance) (direction) (nearest town)			
WELL PURPOSE: (home, irrigation, municipal, industrial)			
WELL COMPLETION DATA:			
(1) diameter (inches) <u>4</u>			
(2) total depth (feet) <u>130</u>			
(3) static water level (feet) <u>60</u> below top of ground.			
(4) casing <u>Plastic</u> <u>130</u> (material) (depth)			
(size) if telescope see back.			
(5) screen <u>20</u> <u>110</u> (length) (depth to top)			
<u>4</u> <u>Plastic</u> (size) (material)			
(6) pump <u>1/2</u> <u>10</u> (HP) (yield gpm)			
<u>Elec.</u> (type power)			
(7) electric log <u>no</u> (yes or no)			
(organization running log)			
(8) how well bottom plugged <u>plugged</u>			
DRILLERS REMARKS:			

CODED

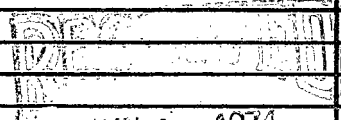


JUN 1 1974

MISS. BD. OF WATER COMMISSIONERS

If well telescopes please sketch and show depths.

GROUND LEVEL

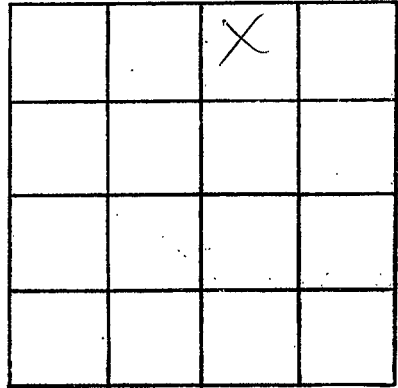

SECTION 4

Please indicate well location X.

ADDITIONAL INFORMATION

If more than one screen,
show locations of each on sketch.