

TATE
F-44
8-29-74

MISSISSIPPI
BOARD OF WATER COMMISSIONERS
416 North State Street
Jackson, Mississippi 39201

WATER WELL DRILLERS LOG

CODED

8-29 1974 Harris Bros Tate
date well completed firm name county well located

LANDOWNER: J. J. Eddins
RT 1
Coldwater
(mailing address)

description of formations encountered	from	to
top soil	0	15
sand & gravel	15	45
gray clay	45	60
sand & clay	60	130
coarse sand	120	150

WELL LOCATION:
sec. 2 T. 5 N. R. 8 E. 15E
1 miles SW of Coldwater
(distance) (direction) (nearest town)

WELL PURPOSE: home
(home, irrigation, municipal, industrial)


- WELL COMPLETION DATA:
- (1) diameter (inches) 4
 - (2) total depth (feet) 150
 - (3) static water level (feet) 80 ^{below} top of ground.
 - (4) casing Plastic, 136 (material) (depth)
4 (size) if telescope see back.
 - (5) screen 14 (length) 136 (depth to top)
#8 Plastic (size) (material)
 - (6) pump 3/4 (HP) 10 (yield gpm)
elec (type power)
 - (7) electric log no (yes or no)
 - (organization running log)
 - (8) how well bottom plugged solid

DRILLERS REMARKS:

DISCONTINUED
MAR 17 1975

If well telescopes please sketch and show depths.

GROUND LEVEL

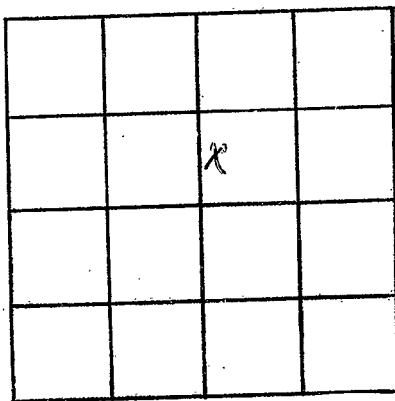

SECTION 2

Please indicate well location X.

ADDITIONAL INFORMATION

If more than one screen, show locations of each on sketch.