

LATE  
F 45  
8-30-74

MISSISSIPPI  
BOARD OF WATER COMMISSIONERS  
416 North State Street  
Jackson, Mississippi 39201

CODED

WATER WELL DRILLERS LOG

8-30 1974 Harris Bros. Late  
date well completed firm name county well located

LANDOWNER:  
Francis Morgan  
pt. 1 Coldwater  
(mailing address)

description of formations encountered	from	to
<u>top soil</u>	<u>0</u>	<u>15</u>
<u>sand &amp; gravel</u>	<u>15</u>	<u>45</u>

WELL LOCATION:  
sec. ~~11~~ 5 T S N R 8 E  
2 miles SW of Coldwater  
(distance) (direction) (nearest town)

<u>clay &amp; sand</u>	<u>45</u>	<u>125</u>
<u>coarse sand</u>	<u>125</u>	<u>140</u>

WELL PURPOSE: home  
(home, irrigation, municipal, industrial)



WELL COMPLETION DATA:  
(1) diameter (inches) 4  
(2) total depth (feet) 140  
(3) static water level (feet) 80 below above top of ground.  
(4) casing Plastic 133  
(material) (depth)  
4 If telescope see back.  
(size)  
(5) screen 7 133  
(length) (depth to top)  
008 Plastic  
(size) (material)  
(6) pump 3/4 10  
(HP) (yield gpm)  
elec.  
(type power)  
(7) electric log no  
(yes or no)  
(organization running log)  
(8) how well bottom plugged solid

DRILLERS REMARKS:

100  
105  
110  
MAR 17 1975

If well telescopes please  
sketch and show depths.

GROUND LEVEL

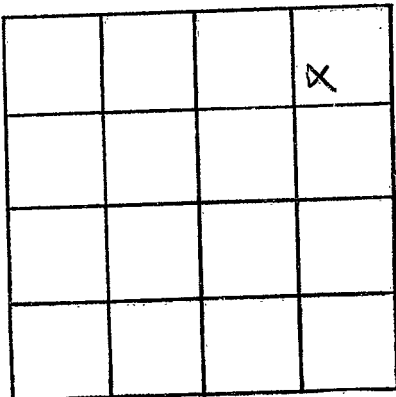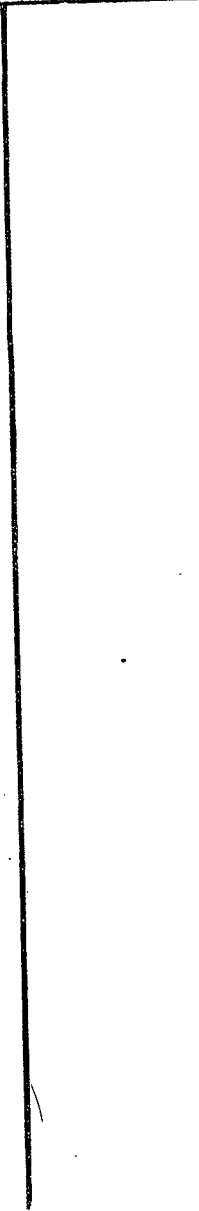

SECTION 11

Please indicate well location X.

ADDITIONAL INFORMATION

---

---

If more than one screen,  
show locations of each on sketch.