

LATE  
F 47  
10-15-74

MISSISSIPPI  
BOARD OF WATER COMMISSIONERS  
416 North State Street  
Jackson, Mississippi 39201

CODED

WATER WELL DRILLERS LOG

10-15 1974 Harris Bros. Tate  
date well completed firm name county well located

LANDOWNER: Northwest  
Junior College Farm  
Senatobia  
(mailing address)

| description of formations encountered | from | to  |
|---------------------------------------|------|-----|
| top soil                              | 0    | 20  |
| white clay                            | 20   | 50  |
| clay + sand                           | 50   | 110 |
| coarse sand                           | 110  | 160 |

WELL LOCATION:  
sec 26 T-5 N R-8 E 15E  
2 miles W of Senatobia  
(distance) (direction) (nearest town)

WELL PURPOSE:  
(home, irrigation, municipal, industrial)


- WELL COMPLETION DATA:
- (1) diameter (inches) 4
  - (2) total depth (feet) 160
  - (3) static water level (feet) 100 <sup>below</sup>/<sub>above</sub> top of ground.
  - (4) casing Plastic 130  
(material) (depth)  
4 (size) if telescope see back.
  - (5) screen 30 130  
(length) (depth to top)  
008 Plastic  
(size) (material)
  - (6) pump 2 30  
(HP) (yield gpm)  
elec.  
(type power)
  - (7) electric log NO  
(yes or no)
  - (organization running log)
  - (8) how well bottom plugged did

DRILLERS REMARKS:

RECEIVED  
OCT 10 1975

If well telescopes please sketch and show depths.

GROUND LEVEL

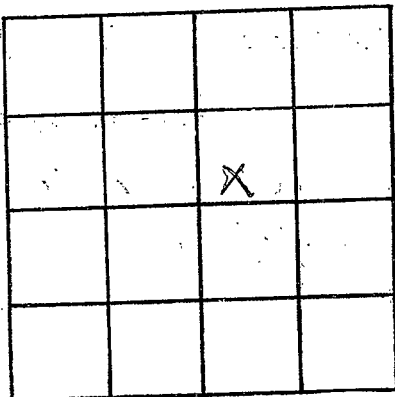

SECTION \_\_\_\_\_

Please indicate well location X.

ADDITIONAL INFORMATION

Lined area for additional information.

If more than one screen, show locations of each on sketch.