

HICKS WATER WELL CO.

30242 HWY 1 EAST
 SENATOBIA, MS 38668

MISSISSIPPI DEPARTMENT OF ENVIRONMENTAL
 QUALITY

Office of Land and Water Resources

P. O. Box 10631
 Jackson, MS 39289-0631
 WATER WELL DRILLERS LOG

COUNTY WELL LOCATED TATE	
WELL NUMBER F-57	CODED
DATE WELL COMPLETED 12-31-02	

PERMIT NUMBER
NAME OF DRILLING FIRM Hicks Drilling Co.

NAME & MAILING ADDRESS OF LANDOWNER Preston McKay			
Oakley Rd.			
Latitude:			
Longitude: Senatobia, MS 38668			
WELL LOCATION	SEC	TOWNSHIP	RANGE
	13	5 N	8 E
DISTANCE	DIRECTION	NEAREST TOWN	
1 Miles	N	of Senatobia	
OTHER LANDMARK			
WELL PURPOSE: Home, Irrigation, Municipal, Industrial, Fish Pond, etc.			

PUMP DATA			
PUMP TYPE (Circle One):			
<input checked="" type="checkbox"/> Submersible	<input type="checkbox"/> Turbine	<input type="checkbox"/> Jet	<input type="checkbox"/> Flowing Well
Other (Describe)			
POWER TYPE (Circle One):			
<input checked="" type="checkbox"/> Electric	<input type="checkbox"/> Tractor	<input type="checkbox"/> Diesel	<input type="checkbox"/> Gasoline, <input type="checkbox"/> Butane
Other (Describe) H/P 1/2			

DESCRIPTION OF FORMATIONS ENCOUNTERED	FROM	TO
Sand	0	10
Red Sand + Clay	10	25
Gravel	25	75
White Sand	75	150

WELL DATA		
Well Depth 143	Casing Diameter (In.) 4	Casing Length (Ft.) 133
Type of Casing PVC	Hole Depth 150'	Depth to Static Water Level 40'
TYPE OF COMPLETION: (Circle One or More):		
<input checked="" type="checkbox"/> Gravel Packed	<input type="checkbox"/> Underreamed	<input type="checkbox"/> Telescoped
<input type="checkbox"/> Natural Development	<input type="checkbox"/> Open Hole	<input type="checkbox"/> Other
(Describe)		

WELL GROUTED TO A DEPTH OF **20** FEET
 Type Grout (circle one): Cement, Bentonite, or **Mix**

SCREEN DATA		
Diameter - Inches 4	Length - Feet 10	Slot Size - Inches .013
Screen Type PVC slotted	Depth to Bottom - Feet 133'	

RECEIVED

FEB 27 2003

BY: OLWR

Top of Lap Pipe or Reduction in Casing

FEET IF TELESCOPED OR MORE THAN ONE SCREEN: USE BACK PAGE


I certify that the well was drilled, constructed and completed in accordance with all applicable Requirements of the Mississippi Department of Environmental Quality and/or the Mississippi Department of Health regulations and state laws.

 **0-323**
 Signature of Licensed Driller and License No.

2/24/03
 Date

If well telescopes please sketch and show depths.

GROUND LEVEL

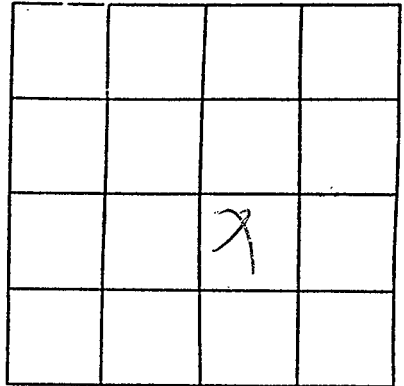

SECTION 13

Please indicate well location X.

Pump Capacity (GPM)	No. of Stages	Setting Depth
10		60 FT.

PUMP TEST

Well yielded _____ GPM with
a drawdown of 7.2 ft.
after _____ hours of pumping

LOG DATA

TYPE OF LOG RUN (Circle One):
Electric, Gamma Ray, Density, No Log Run,
Other (Describe) Some Neutron

Name of Organization Running Log

GEOLOGIC DATA (Office Use Only)

Surface Elev.	Geologic Unit	Unit Thickness	Depth to Top
Subs. SWL	Date	Analysis	Aquifer Test

Driller's Remarks

If more than one screen,
show location of each on sketch.