Sta	te Well Report		
	t 1 – Driller's Log		
Mississinni Den	artment of Environmental Quality Aquifer:		
	Land and Water Resources P.O. Poy. 10631 Well #: F-72		
Driller: Jones w. Mason	F.O. Box 10031		
Date drilling completed: 4-14-05	kson, MS 39289-0631 (601)961-5210		
	601)354-6938 (fax) E-log #:		
Department at the above address within 30 days of	the license holder responsible for the work and filed with the of completion of drilling of the well or borehole.		
Information on Well Owner (Landowner if borehole is not for a water well)	Well or Borehole Location		
	Latitude: 34 . 40 , 605 ", Longitude: 90 . 05 , 853"		
Owner Name To Vought	$- \frac{\text{Latitude: } \underline{34 \circ 40}, \underline{605}, \text{Longitude: } \underline{90 \circ 05}, \underline{853}, \underline{36}}{\underline{36}}$ Method of Lat/Long (circle one): Conventional Survey,		
Mailing Address: wolsh rd.	Method of Lat/Long (circle one): Conventional Survey,		
	USGS quad, Hand-held GPS, Survey-grade GPS		
hidden volley subdivision.			
Colduster ms. 38618 City State Zip Code			
City State Zip Code	Distance Direction Nearest Town Milesof_a/Fabutla		
Telephone No. (602) 284 . 9680	Miles JE of ar Fobulta		
	l / Borehole Data		
Date drilling started: $4 - 14 - 36$ Date drilling completed:	$1 + 14 - \infty$ Hole depth: $170'$ Hole diameter: $8''$		
Location of the source of any surface water used for drilling: Method of dosing and volume of Chlorine used in drilling an	NA nd development: レス		
Logs run (circle all applicable) No log run Electric Gami Name of organization running log(s):	Logs run (circle all applicable) No log run Electric Gamma Ray Density Sonic Neutron Other:		
Purpose of borehole (check one): Water Well Geotechnic	al/Geological Investigation Ground Source Heat Pump		
Seismic SurveyOther (a	lescribe)		
Purpose of Well (check one): Home <u></u> Industrial Public	SupplyIrrigationFish CultureOther:		
If a flowing well, method of flow regulation: Valve ${\sim}$	Other (describe)		
Static Water Level: <u>75</u> feet above or below circle one) land surface Date measured: <u>4-14-06</u>			
Method of Measurement (circle one) steel tape electric tape air line other: String (weight-			
Well depth: $\frac{120}{100}$ Well grouted to a depth of <u>l0</u> feet Type of grout (circle one): Neat Cement Bentonite Mix			
Casing length: 160 feet Casing diameter: 4 inches Type of casing:			
Screen length: $1^{\circ}$ feet Screen diameter: $4$ inches Type of screen: $\rho_{4}$			
Screen slot size: inches Setting depth: From feet to feet			
Type of completion (circle all applicable). Gravel packed Underreamed Telescoped Open hole Natural Development			
Other (describe):			
Top of lap pipe or reduction in casing: feet. If telescoped or more than one screen, describe on next page			
Form: OLWR-SWR-1A			

۷

2

RECEIVED MAY 11 2006 BY: OLWR


Description of formations encountered must be provided for all wells and boreholes, unless specifically exempted by regulations

## The sketch below only required for water wells

If well telescopes, show depths on sketch. Groun

d Level	Description of Formations Encountered	From (depth)	To (depth)
	- Clay dirt.	Ground Level	30
	Grevel	30	50
	white cley	50	25
	Blue cleri	75	140
	white saud	140	(20-
			<u>├</u>
			<u>+</u>

If more than one screen, show location of each on sketch

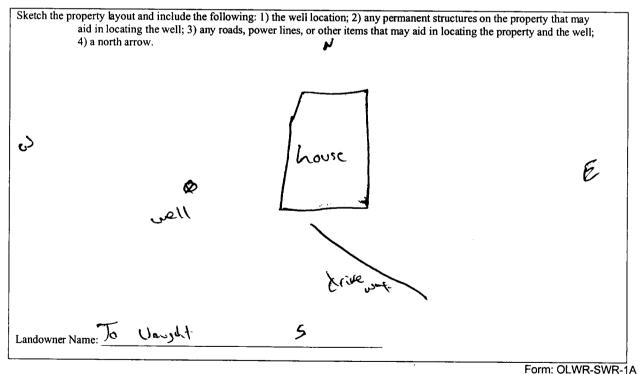

I certify that the well/borehole was drilled, constructed, and completed in accordance with all applicable requirements of the Mississippi Department of Environmental Quality and the Mississippi Department of Health regulations, if applicable, and state laws.

5-8-06 Print Name of Responsible Licensee and License No. ' Date

Signature of Licensee

RECEIVED MAY 1 1 2006 BY: OLWR

STATE WELL REFORT				
County: Tote	Part 2 Pump Installer's Completion Report	For Office Use Only:		
Permit #:	Mississippi Department of Environmental Quality	Aquifer:		
Driller: Jones w. Mason	Office of Land and Water Resources P.O. Box 10631			
Date completed: 4-14-06	Jackson, MS 39289-0631 (601)961-5210	Well #:		
Copy information from block on Part 1	(601)354-6938 (fax)	Elevation:		

STATE WELL DEDODT

report must be attached and both parts filed with the Department at the above address within 30 days of well completion.			
Well Owner Information	Well Location		
Owner Name: Jo Vouget.	Latitude: 34,40,605 Longitude: 70,05,853		
Mailing Address: walsh rd.	Method of Lat/Long (check one): Conventional Survey,		
hidden Volley Subdivisor	USGS quad, Hand-held GPS, Survey-grade GPS		
Coldwaler MS 38018 City State Zip Code	<u>NW 1/ NW 1/ Sec 6 T 55 R 8W</u>		
· · ·	Distance Direction Nearest Town		

2 Miles SE of artabutta

Telephone No. (602) 284 - 9680

Pump Type Circle one		Power Type Circle one			
Air Lift	Jet	Submersible	Diesel Engine	Gasoline Engine	Natural Gas
Bucket	Piston	Turbine	Electric Motor	Hand	Tractor PTO
Centrifugal	Rotary	Flowing Well	Windmill	Other (specify):	
Other (specify):			Horse Power Rating of	of Motor:	
Date Pump Installed: _	4-14-06	<b>)</b>	Setting Depth:	(00)	feet
Rated Pump Capacity:	12	Gallons Per Minute	Number of Stages:	()	

Pump Test Data	Method of Measuring Water Level
Date Well Tested: 4-14-06	Circle one
Static Water Level (A): 75 Feet Below Land Surface	Air Line Electric Measuring Line Steel Tape
Static water Level (A): 7 5 Feet Below Land Surface	Other (specify): String (weight
Pumping Water Level (B): <u>PA</u> Feet Below Land Surface	
Drawdown $[(B) - (A)]$ : <u>Feet Below Land Surface</u>	For flowing well, measured shut in head:
Test Pumping Rate: Gallons Per Minute	Well yielded GPM with a drawdown of
Duration of Pump Test (minimum 4 hours): <u>Ə4</u> hours	$\underline{NA}$ feet after $\underline{\partial 4}$ hours of pumping

I HEREBY CERTIFY that the above statements are true to the best o	f my knowledge.	
Teres w. Moson,	Gours un Maria	
Print Name of Pump Installer and License No. (if applicable)	Signature of Pump Installer	
		Form: OLWR-SWR-1B

MAY 1 1 2006 BY: OLWR