
F	State W	ell Report		
County: Tete	Part 1 – Driller's Log		For Office Use Only:	
Permit #:	Mississippi Department of Environmental Quality		Aquifer:	
Driller: Jones W. Moson	Office of Land and Water Resources P.O. Box 2309		Well #: <u>F97</u>	
		n, MS 39225 961- 5210	L. S. Elevation:	
Date drilling completed: 2-14-13		1- 5228 (fax)	E-log #:	
State Law requires that this report be prepared by the license holder responsible for the work and filed with the Department at the above address within 30 days of completion of drilling of the well or borehole.				
Information on Well C			or vorenote.	
(Landowner if borehole is not fo	or a water well)	Latitude: 34 o 46 , 33,3	4, Langitude: 90 oct , 43.80	
Owner Name wheeler Hom	6.5	2.2	2 Longitude. 4 3	
Mailing Address: 139 Luke	love	Latitude: 34 ° 46 , 33,34, Longitude: 90 ° 01 , 43,89, Method of Lat/Long (circle one): Conventional Survey,		
LOT S3 che	my dale sus.		GPS, Survey-grade GPS	
		Not 1/2 Sec 3	Twn Ss Rng Sw	
(<u>aldusates my</u> City Stat	e Zip Code	Sw 5E Distance Direction	Nearest Town of ArkasuHa	
Telephone No. (901) 830 - 3629	1	4'14 Miles _SE	of Arkabutla	
	TV 11 / D			
0	Well / Bore			
Date drilling started: <u>3-14-13</u> Date dri	lling completed: 4-11-13	Hole depth: 155	Hole diameter: 63/4	
Location of the source of any surface water Method of dosing and volume of Chlorine	r used for drilling: NAused in drilling and develo	opment: <u>~A</u>		
Logs run (circle all applicable): No log run Name of organization running log(s):	Electric Gamma Ray	Density Sonic Neutron	Other:	
Purpose of borehole (check one): Water We	ell <u> </u>	ogical Investigation Ground	Source Heat Pump	
Seismic S	urveyOther (describe)			
If drilling is not related	to water well construction	$\frac{}{1.5}$, skip the remainder of this blo	ock	
Purpose of Well (check one): Home $\underline{\checkmark}$ In			Other:	
If a flowing well, method of flow regulation	n: Valve Ot	her (describe)		
Static Water Level: 48 feet above of below (circle one) land surface Date measured: 2-15-13				
Method of Measurement (circle one) steel tape electric tape air line other: String (weight				
Well depth: 155 Well grouted to a depth of 10 feet Type of grout (circle one): Neat Cement Bentonite Mix				
Casing length: 135 feet Casing diameter: 4 inches Type of casing: pvc				
Screen length: 10 feet Screen diameter: 1 inches Type of screen: P-10				
Screen slot size: Olo inches Setting depth: From 135 feet to 155 feet				
Type of completion (circle all applicable): Gravel packed Underreamed Telescoped Open hole Natural Development				
Other (describe): ~~				
Top of lap pipe or reduction in casing:feet. If telescoped or more than one screen, describe on next page				
			Form: OLWR-SWR-1A (04/08)	

Description of formations encountered must be provided for all wells and boreholes, unless specifically exempted by regulations

If well telescopes, s	show depths on sketch.
Ground Level_	
	<u> </u>

Description of Formations Encountered	From (depth)	To (depth)
clay dirt.	Ground Level	15
sed sand	15	40
Olve clay	40	90
while soud	90	155
		<u> </u>
		
	1	<u> </u>
		<u> </u>
		<u> </u>
		
	 	
		
L	1	1 !

If more than one screen, show location of each on sketch

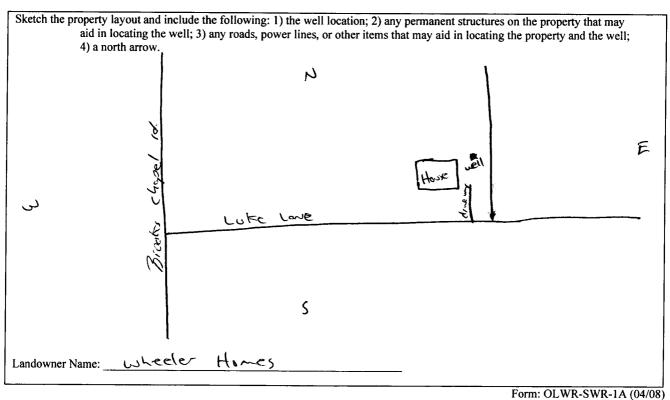

Form: OLWR-SWR-1A (04/08)

I certify that the well/borehole was drilled, constructed, and completed in accordance with all applicable requirements of the

Mississippi Department of Environmental Quality and	d the Mississippi D	Department of Health regulations, if app	licable, and state
Mississippi Department of Environmental Quality and laws.			RECEIVEL
Jones W. Meson 0-620	3-12-13	his w. Man-	
Print Name of Responsible Licensee and License No.	Date	Signature of Licensee	MAR 1 4 2013

STATE WELL REPORT

Permit #: Driller: Jones W. Moson Date completed: 3-15-13 Copy information from block on Part 1

Part 2

Pump Installer's Completion Report Mississippi Department of Environmental Quality Office of Land and Water Resources P.O. Box 2309 Jackson, MS 39225

(601)961-5210 (601)961-5228 (fax)

For	Office Use Only:
Aquifer:	
Well #:	F97

This part of the report must be completed by a licensed water well contractor or a licensed pump installer. A copy of Part 1 of the

report must be attached and both parts filed with the Department a			
Well Owner Information	Well Location		
Owner Name: wheeler Homes	Latitude: 34, 40, 33,34 Longitude: 90, 61, 42,80		
Mailing Address: 139 Lote loug	Method of Lat/Long (check one): Conventional Survey,		
LOT 53 cherrydole sub.	USGS quad, Hand-held GPS, Survey-grade GPS		
City State Zip Code	Nearest Town		
Telephone No. (901) 830~ 3639	414 Miles SE of Arkabutla		

	Pump Type Circle one			Power Type Circle one	
Air Lift	Jet	Submersible	Diesel Engine	Gasoline Engine	Natural Gas
Bucket	Piston	Turbine	Electric Motor	Hand	Tractor PTO
Centrifugal	Rotary	Flowing Well	Windmill	Other (specify):	
Other (specify):			Horse Power Rating	of Motor: 3/4	
Date Pump Installed:	2-15-13	· · · · · · · · · · · · · · · · · · ·	Setting Depth:	(00	_feet
Rated Pump Capacity: _	10	_Gallons Per Minute	Number of Stages:	88	_

Pump Test Data	Method of Measuring Water Level Circle one		
Date Well Tested: $\frac{\partial -15 - 13}{\partial -15}$	Air Line Electric Measuring Line Steel Tape		
Static Water Level (A): Feet Below Land Surface	Other (specify): String Line Steel Tape		
Pumping Water Level (B): Feet Below Land Surface	outer (speedy).		
Drawdown [(B) – (A)]: Feet Below Land Surface	For flowing well, measured shut in head:feet		
Test Pumping Rate: Gallons Per Minute	Well yieldedGPM with a drawdown of		
Duration of Pump Test (minimum 4 hours): 24 hours	feet afterhours of pumping		

I HEREBY CERTIFY	that the above	statements are true to	the best of my	knowledge.
To	M-5	() (62 0		\bigcirc

MAR 1 4 2013

Print Name of Pump Installer and License No. (if applicable)

Signature of Pump Installer

ller **BY*** () **V** Form: OLWR-SWR-1B (04/08)