

STATE WELL REPORT

Part 1

Driller's Log

Mississippi Department of Environmental Quality
Office of Land and Water Resources
P.O. Box 2309
Jackson, MS 39225-2309
(601)961-5210
(601)360-0535 (fax)

For Office Use Only:

Well #: F102
Aquifer: _____
E-Log #: _____

County: Tate
Permit #: _____
Driller: Bob Smith
Date drilling completed: 4-24-14

State Law requires that this report be prepared by the license holder responsible for the work and filed with the Department at the above address within 30 days of completion of drilling of the well or borehole.

Well Owner Information <small>(Landowner if borehole is not for a water well)</small>	Well or Borehole Location
Owner Name: <u>Walteren Homes</u>	Latitude: <u>34°40'42.37"N</u> Longitude: <u>90°02'01.07"W</u>
Mailing Address: <u>LOT # 7</u>	Method of Lat/Long (check one): Conventional Survey <input type="checkbox"/> ⁴² <input checked="" type="checkbox"/> ⁰¹
<u>CHERRY OAK</u>	USGS quad _____, Hand-held GPS _____, Survey-grade GPS _____
<u>Coldwater</u> MS. <u>38618</u>	<u>SE 1/4 NW 1/4, Sec 0-3 T15S R18W</u>
City _____ State _____ Zip Code _____	<u>4</u> Miles <u>S/W</u> of <u>Coldwater</u>
Telephone No. <u>(901) 830-2629</u>	(Distance) (Direction) (Nearest Town)

Well / Borehole Data

Date drilling started: 4-24-14 Date drilling completed: 4-24-14 Hole depth: 185 Hole diameter: 8

Location of the source of any surface water used for drilling: _____

Method of dosing and volume of Chlorine used in drilling and development: 5 ppm

Logs run (circle all applicable): No log run Electric Gamma Ray Density Sonic Neutron Other: _____

Name of organization running log(s): _____

Purpose of borehole (circle one): Water Well Geotechnical/Geological Investigation Ground Source Heat Pump
 Seismic Survey Other (describe) _____

If drilling is not related to water well construction, skip the remainder of this block

Purpose of Well (circle all applicable): Home Industrial Public Supply Irrigation Fish Culture

Other (describe): _____

If a flowing well, method of flow regulation: Valve _____ Other (describe) _____

Static Water Level: 80 feet [above or below] land surface Date measured: 4-24-14
(circle one)

Method of measurement (circle one): Steel tape Electric tape Air line Other (describe): LINE + WEIGHT

Well depth: 185 Well grouted to a depth of: 10 feet Type of grout (circle one): Neat Cement Bentonite Mix

Casing length: 125 feet Casing diameter: 4 inches Type of casing: PVC

Screen length: 10 feet Screen diameter: 4 inches Type of screen: PVC

Screen slot size: 13 inches Setting depth: From 125 feet to 185 feet

Type of completion (circle all applicable): Gravel packed Underreamed Open hole Natural Development

Other (describe): _____


Top of lap pipe or reduction in casing: _____ feet

If telescoped or more than one screen, describe on next page

Lot 7


If well telescopes please sketch below and show depths.

Ground Level

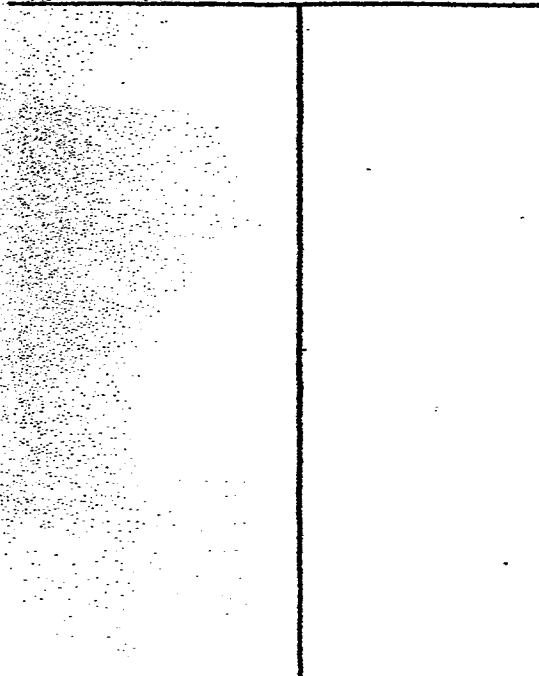

Description of Formations Encountered	From	To
TOP SOIL	0	5
BROWN CLAY	5	31
REDDISH CLAY	31	48
GRAVEL	48	53
CLAY CLAY	53	151
WHITE CLAY	151	160
WHITE SAND	160	185

If more than one screen, show location of each on sketch

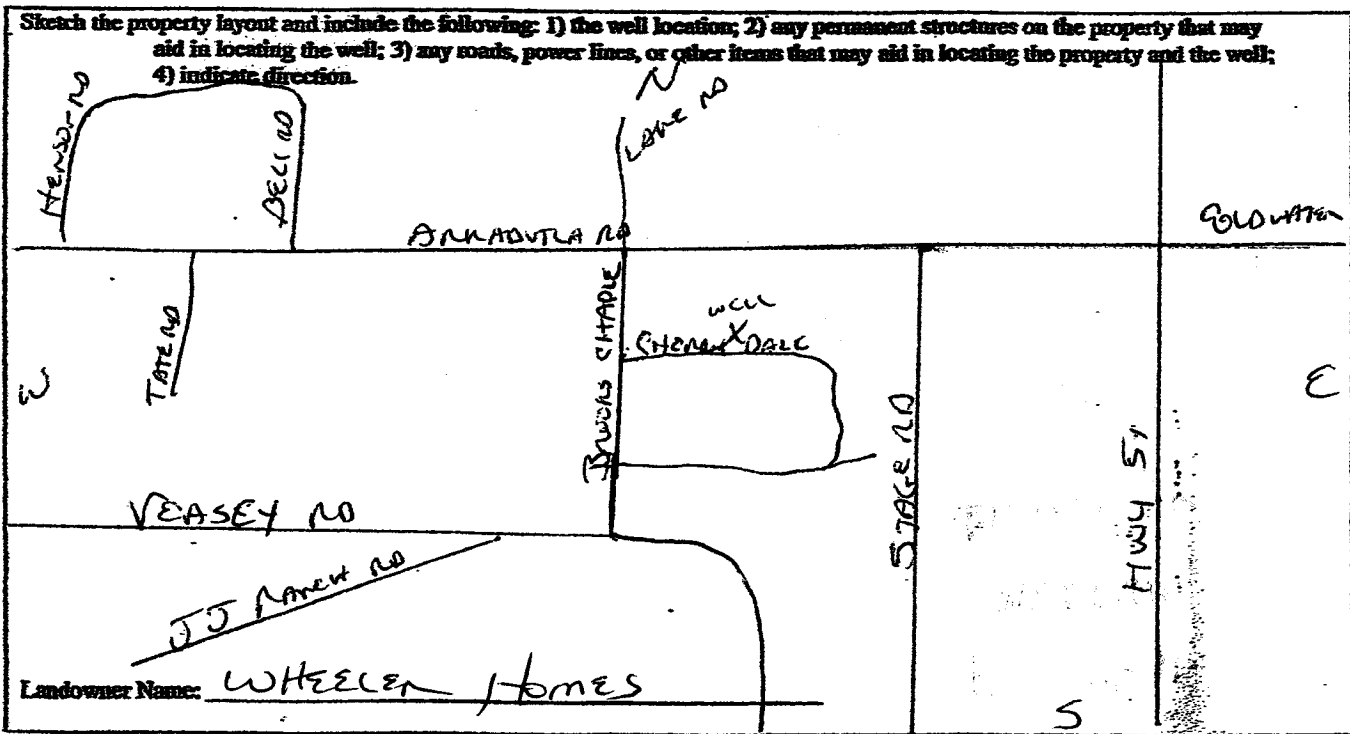

STATE WELL REPORT

Part 2

Pump Installer's Completion Report
 Mississippi Department of Environmental Quality
 Office of Land and Water Resources
 P.O. Box 2309
 Jackson, MS 39225-2309
 (601)961-5210
 (601) 360-0535 (fax)

County: TATE
 Permit #: _____
 Driller: BOB SMITH
 Date completed: 4-24-14
Copy information from block on Part 1

For Office Use Only:

Well #: F102
 Aquifer: _____

This part of the report must be completed by a licensed water well contractor or a licensed pump installer. A copy of Part 1 of the report must be attached and both parts filed with the Department at the above address within 30 days of well completion.

Well Owner Information	Well Location
Owner Name: <u>Wheeler Hines</u>	Latitude: <u>34°48'42.37"N</u> Longitude: <u>90°02'0.07"W</u>
Mailing Address: <u>LOT #7</u>	Method of Lat/Long (check one): Conventional Survey _____
<u>OHENRY Dore</u>	USGS quad _____, Hand-held GPS _____, Survey-grade GPS _____
<u>COLUMBIA MS. 38618</u>	<u>SE 1/4 NW 1/4, Sec 3 T15S R18W</u>
City _____ State _____ Zip Code _____	<u>4</u> Miles <u>S/W</u> of <u>COLUMBIA</u>
Telephone No. <u>(901) 830-2629</u>	(Distance) (Direction) (Nearest Town)

Pump Type (circle one)

Submersible Turbine Air Lift Centrifugal Flowing Well Jet Piston Rotary Other (describe): _____

Date Pump Installed: 4-24-14 Rated Pump Capacity: 10 Gallons Per Minute

Is This Pump (circle one): New Repaired Replacement

Power Type (circle one)

Electric Diesel Gasoline Natural Gas Tractor PTO Windmill Other (describe): _____

Horse Power Rating of Motor: 3/4 Setting Depth: 120 feet Number of Stages: 8

Pump Test Data for Non Flowing Well

Date Well Tested: 4-24-14 Duration of Pump Test (minimum 4 hours): _____ hours

Static Water Level (A): 80 Feet Below Land Surface Pumping Water Level (B): _____ Feet Below Land Surface

Drawdown [(B) - (A)]: _____ Feet Below Land Surface Test Pumping Rate: 12 Gallons Per Minute

Method of measurement (circle one): Steel tape Electric tape Air line Other (describe): LINE & WEIGHT

Pump Test Data for Flowing Well

Measured shut in head: _____ feet.

Well yielded 12 GPM with a drawdown of _____ feet after _____ hours of pumping

Meter Installation

Meter Manufacturer: _____ Meter Serial Number: _____

Meter Model Number/Name: _____ Type of Meter: _____

Totalizer Register Unit and Multiplier Factor (AF x .001, gal x 1000, etc): _____

Installation Date: _____ Meter installed by: _____

Is This Meter (circle one): New Repaired Replacement

Important: By submitting the above information you are certifying that this meter was installed to manufacturer standards. For agricultural wells, a list of approved meters is on the MDEQ website.

I HEREBY CERTIFY that the above statements are true to the best of my knowledge.

BOB SMITH 0645 5-19-14 _____
 Print Name of Pump Installer and License No. (if applicable) Date Signature of Pump Installer

LOT 7