

MISSISSIPPI BOARD OF WATER COMMISSIONERS

WATER WELL DRILLERS LOG

Date: July 23, 1966, Driller: Shelby Neyman County Fate
(Name)


| (1) Owner of Land: | Description & Color of Materials Sand, Clay, Red Clay, Shell, etc. | Thick- ness Feet | Depth Feet |
|---|---|------------------------|---------------|
| <u>Roseborough Co.</u> <small>(Name)</small> | <u>Red clay</u> | <u>20</u> | <u>20</u> |
| <u>Senatobia Miss</u> <small>(Address)</small> | <u>Gravel</u> | <u>20</u> | <u>40</u> |
| (2) Location: <u>NW 1/4, NW 1/4, Sec 36 T5 R8,</u> | <u>Red sand</u> | <u>25</u> | <u>65</u> |
| <u>1/4</u> miles <u>West</u> of <u>Senatobia</u> <small>(distance) (direction) (Nearest Town)</small> | <u>white clay sand</u> | <u>30</u> | <u>95</u> |
| (3) Topography: _____ <small>(Hilly) (Flat) (Level)</small> | <u>white sand</u> | <u>17</u> | <u>112</u> |
| (4) Purpose of Well: <u>Domestic</u> <small>(Domestic Irrigation Municipal, Industrial, Other)</small> | | | |

Information upon completion of well:

- (1) Diameter 2 inches.
- (2) Total Depth 112 feet.
- (3) Water Level 80 feet below top of ground.
- (4) Cased to 105, Size 2 in.
- (5) Screen: Size 90, Length 6 ft.
- (6) Were any formations sealed against pollution?
 _____ yes, no.

If YES depth of formation _____
 Why _____

Drillers Remarks: _____

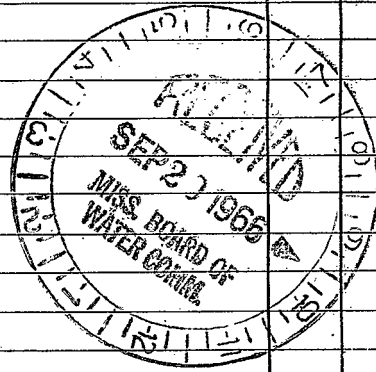

(Use Back Side)

Well No.

