

MISSISSIPPI
 BOARD OF WATER COMMISSIONERS
 416 North State Street
 Jackson, Mississippi 39201

WATER WELL DRILLERS LOG

Date
 7 2004
 7-67

July 5 1967 Shelby Newman Date
 date well completed firm name county well located

LANDOWNER: Sawanpha Payne
 Coldwater Miss
 R. F. D. - 1
 (mailing address)

description of formations encountered	from	to
Red Clay	00	40
white clay	40	120
white sand	120	132 1/2

WELL LOCATION:
 sec. 5 T. 5 N. R. 8 E. S. 34
 3 1/2 miles SE of Arkabutla
 (distance) (direction) (nearest town)

WELL PURPOSE: Home
 (home, irrigation, municipal, industrial)

WELL COMPLETION DATA:
 (1) diameter (inches) 2 in
 (2) total depth (feet) 234
 (3) static water level (feet) 90 below top of ground.
 (4) casing Galvanized 126 (material) (depth)


If telescope see back.
 (5) screen 6 in 90 ft (size) (length) (depth to top)

(6) pump 1/2 HP 4 gal P.M. (size) (material) (yield gpm)

(7) electric log no (type power) (yes or no)


(8) how well bottom plugged no (organization running log) Rubby Seal

DRILLERS REMARKS:

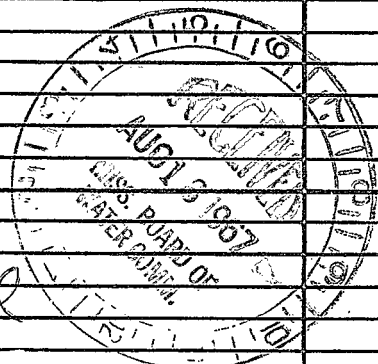

If well telescopes please sketch and show depths.

GROUND LEVEL

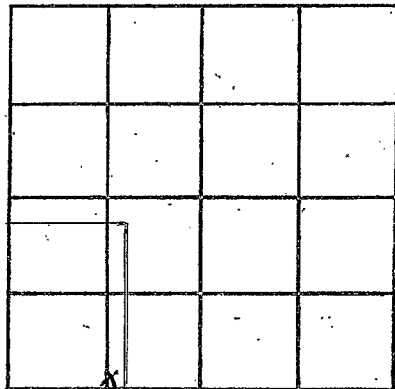

Well SECTION 5

Please indicate well location X.

ADDITIONAL INFORMATION

58⁰⁰ W 95⁰⁰ SW⁴ Sec 5

If more than one screen, show locations of each on sketch.