

Late
7 2005
10-67

MISSISSIPPI
BOARD OF WATER COMMISSIONERS
416 North State Street
Jackson, Mississippi 39201


WATER WELL DRILLERS LOG

Oct 6 1967 Shelly Newman Late
date well completed firm name county well located

LANDOWNER:	description of formations encountered	from	to
W.P. [unclear] Coldwater Miss	Red Clay	0	18
(mailing address)	Red Sand & Gravel	18	95
WELL LOCATION: sec. 6 T 5 N R 8 E 3 miles SE of Arabhatta	White Sand	95	112
(distance) (direction) (nearest town)			

WELL PURPOSE:
(home, irrigation, municipal, industrial)


- WELL COMPLETION DATA:
- (1) diameter (inches) 2
 - (2) total depth (feet) 112
 - (3) static water level (feet) 45 below top of ground.
 - (4) casing Galvanize (material) (depth)
 - (size) if telescope see back.
 - (5) screen 6 ft Stainless Steel (length) (depth to top)
 - 1 1/4 (size) (material)
 - (6) pump 1 (HP) 6 (yield gpm)
 - Electric (type power)
 - (7) electric log No (yes or no)
 - No (organization running log)
 - (8) how well bottom plugged Rubber Seal

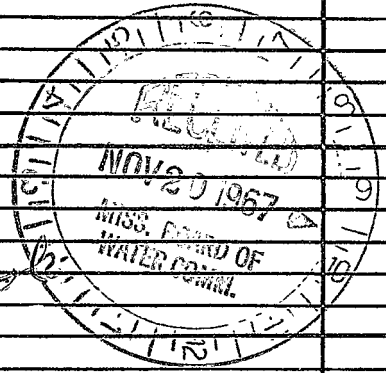

DRILLERS REMARKS:

If well telescopes please sketch and show depths.

GROUND LEVEL

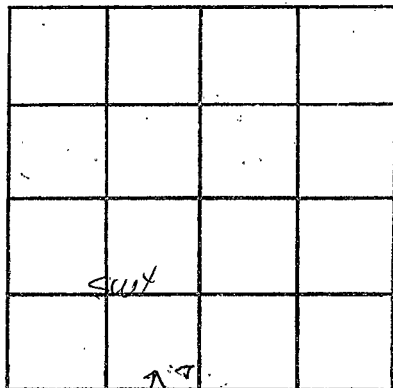

SWT

ART.
WELL

SECTION 6

Please indicate well location X.

ADDITIONAL INFORMATION

If more than one screen, show locations of each on sketch.