

TATE
 Faade
 3-68

MISSISSIPPI
 BOARD OF WATER COMMISSIONERS
 416 North State Street
 Jackson, Mississippi 39201

WATER WELL DRILLERS LOG

March 30 1968 Shelby Neyman Tate
 date well completed firm name county well located


LANDOWNER:	description of formations encountered	from	to
Meawweather Roberson Route 1, Coldwater Miss. (mailing address)	Red clay	0	20
	Red gravel	20	60
	Grey clay	60	105
	Coldwater sand & gravel	105	140
	White sand	140	155

WELL LOCATION:
 sec. 5 T. 5 N. R. 8 E.
 S W
 4 miles W of Coldwater
 (distance) (direction) (nearest town)

WELL PURPOSE: Home
 (home, irrigation, municipal, industrial)

- WELL COMPLETION DATA:
- (1) diameter (inches) 2
 - (2) total depth (feet) 155
 - (3) static water level (feet) 90 below above top of ground.
 - (4) casing Galvanne 147 ft
 (material) (depth)
 _____ if telescope see back.
 (size)
 - (5) screen 105 ft, 6 ft
 (length) (depth to top)
1 1/4", Stainless Steel
 (size) (material)
 - (6) pump 1/2 HP 4
 (HP) (yield gpm)
Electric
 (type power)
 - (7) electric log no
 (yes or no)

 (organization running log)
 - (8) how well bottom plugged Rubber seal

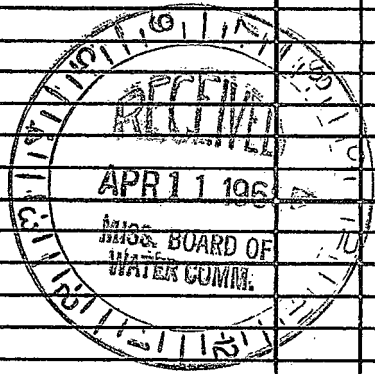


DRILLERS REMARKS:

If well telescopes please sketch and show depths.

GROUND LEVEL

Well

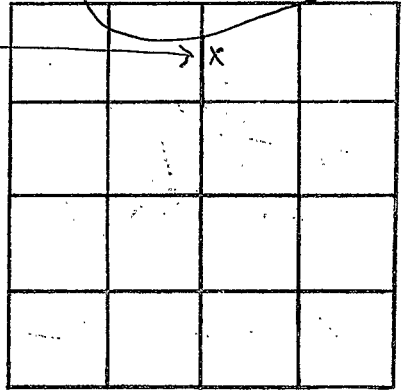

SECTION 5

Please indicate well location X.

ADDITIONAL INFORMATION

If more than one screen, show locations of each on sketch.