

Date
 7 2007
 8-31-68

MISSISSIPPI
 BOARD OF WATER COMMISSIONERS
 416 North State Street
 Jackson, Mississippi 39201

WATER WELL DRILLERS LOG

Aug 31 1968 Roberson & Son Hab Lata
 date well completed firm name County well located

LANDOWNER: Jim Watson
Senatobia, Miss
 (mailing address)


description of formations encountered	from	to
Red Clay + sand	0	40
pea gravel + sand	40	70
sand + clay	70	85
gravel	85	100
Blue Clay + sand	100	130
white sand	130	160

WELL LOCATION:
 sec. 36 T. 5 N R. B E
3 1/4 miles S.W. of Senatobia
 (distance) (direction) (nearest town)

WELL PURPOSE: home
 (home, irrigation, municipal, industrial)

- WELL COMPLETION DATA:
- (1) diameter (inches) 4"
 - (2) total depth (feet) 160
 - (3) static water level (feet) 85 below above top of ground:
 - (4) casing plastic 155
 (material) (depth)
4 if telescope see back.
 (size)
 - (5) screen 5 ft 155
 (length) (depth to top)
4 gravel packed
 (size) (material)
 - (6) pump 3/4 14
 (HP) (yield gpm)
2 1/4 220
 (type power)
 - (7) electric log no
 (yes or no)
 (organization running log)
 - (8) how well bottom plugged Capped

DRILLERS REMARKS: plastic
Water Well

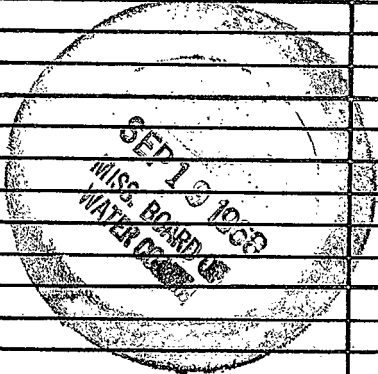

If well telescopes please sketch and show depths.

GROUND LEVEL

	X		

SECTION 36

Please indicate well location X.

ADDITIONAL INFORMATION

If more than one screen, show locations of each on sketch.