

**MISSISSIPPI
BOARD OF WATER COMMISSIONERS**
416 North State Street
Jackson, Mississippi 39201

WATER WELL DRILLERS LOG

Date
F 2008
8-68

aug 28 19 68 Shelby Nymman Date
date well completed firm name county well located

LANDOWNER:

Mrs Mable Savage
Coldwater Miss
(mailing address)

**description of formations
encountered**

description of formations encountered	from	to
Red clay	0	9.0
Red gravelly sand	9.0	5.0
white clay	5.0	11.0
white sand	11.0	13.4


WELL LOCATION:

sec. 3 T. 5 N. R. 8 E
S W
3 miles west of Coldwater
(distance) (direction) (nearest town)

WELL PURPOSE: home
(home, irrigation, municipal, industrial)

WELL COMPLETION DATA:


- (1) diameter (inches) 2
- (2) total depth (feet) 13.4
- (3) static water level (feet) 4.8 below/above top of ground.
- (4) casing Galvanz 12.6
(material) (depth)
(size) if telescope see back.
- (5) screen 5 ft
(length) (depth to top)
1/4" stainless steel
(size) (material)
- (6) pump 1 7
(HP) (yield gpm)
Electric
(type power)
- (7) electric log NO
(yes or no)
no
(organization running log)
- (8) how well bottom plugged Rubby Seal

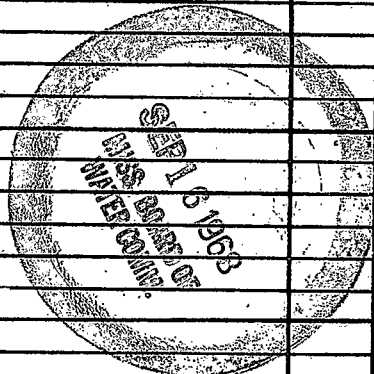

DRILLERS REMARKS:

If well telescopes please sketch and show depths.

GROUND LEVEL

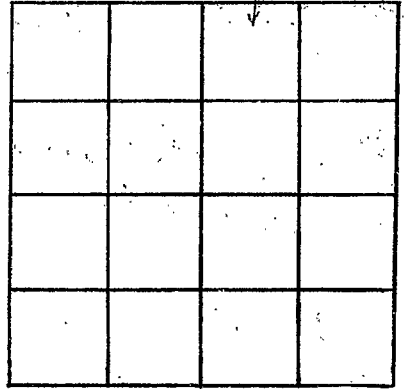

SECTION _____

Please indicate well location X.

ADDITIONAL INFORMATION

If more than one screen,
show locations of each on sketch.