

TATE
 F 2009
 6-25-75

MISSISSIPPI
 BOARD OF WATER COMMISSIONERS
 416 North State Street
 Jackson, Mississippi 39201

WATER WELL DRILLERS LOG

6-25 1975 Harris Bros. Tate
 date well completed firm name county well located

LANDOWNER: W.A. Bruchillier
 Rt. 1
 Coldwater
 (mailing address)

WELL LOCATION:
 sec. 4 T 5 N R 8 E
 3 miles W of Coldwater
 (distance) (direction) (nearest town)

WELL PURPOSE: home
 (home, irrigation, municipal, industrial)

WELL COMPLETION DATA:
 (1) diameter (inches) 4
 (2) total depth (feet) 115
 (3) static water level (feet) 60 below top of ground.
 (4) casing plastic, 108 (material) (depth)
 4 (size) if telescope see back.
 (5) screen 7 (length) 108 (depth to top)
 008 plastic (size) (material)
 (6) pump 3/4 (HP) 10 (yield gpm)
 elec (type power)
 (7) electric log no (yes or no)
 (organization running log)
 (8) how well bottom plugged solid

Description of formations encountered	from	to
top soil	0	20
red sand & red gravel	20	45
clay sand	45	100
coarse sand	100	115


APR 12 1975

MISS. Bd. of WATER COM.

DRILLERS REMARKS:

If well telescopes please sketch and show depths.

GROUND LEVEL

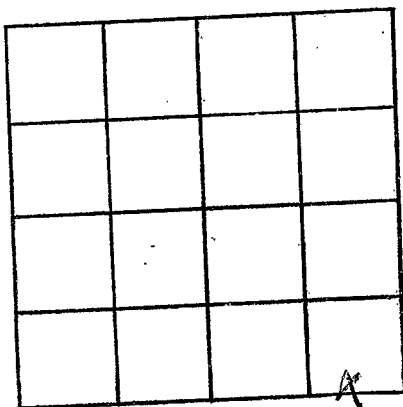

SECTION 4

Please indicate well location X.

ADDITIONAL INFORMATION

If more than one screen,
show locations of each on sketch.