

TATE  
 F 200  
 8-11-75

MISSISSIPPI  
 BOARD OF WATER COMMISSIONERS  
 416 North State Street  
 Jackson, Mississippi 39201

WATER WELL DRILLERS LOG

8-11-75 date well completed 1975 Harris Bros. firm name Tate county well located

LANDOWNER: Bob Blair  
 Rt. 2  
 Coldwater  
 (mailing address)

description of formations encountered	from	to
top soil	0	70
fine sand	70	85
coarse sand	85	100

WELL LOCATION:  
 sec. 2 T. 45 N. R. 8 E.  
 1 1/2 miles W of Coldwater  
 (distance) (direction) (nearest town)

WELL PURPOSE: home  
 (home, irrigation, municipal, industrial)


- WELL COMPLETION DATA:
- (1) diameter (inches) 4
  - (2) total depth (feet) 100
  - (3) static water level (feet) 60 below top of ground.
  - (4) casing plastic, 93 (material) (depth)  
 4 (size) if telescope see back.
  - (5) screen 7, 93 (length) (depth to top)  
 008, plastic (size) (material)
  - (6) pump 3/4 (HP) 10 (yield gpm)  
 elec (type power)
  - (7) electric log no (yes or no)  
 (organization running log)
  - (8) how well bottom plugged solid

DRILLERS REMARKS:

DECEMBER 1 1975  
 ADD 1 1 1976

If well telescopes please sketch and show depths.

GROUND LEVEL

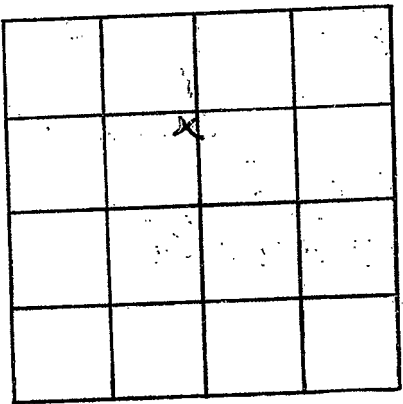

SECTION 2

Please indicate well location X.

ADDITIONAL INFORMATION

Lined area for additional information.

If more than one screen, show locations of each on sketch.