

Tate  
 F 201  
 4-28-76

MISSISSIPPI  
 BOARD OF WATER COMMISSIONERS  
 416 North State Street  
 Jackson, Mississippi 39201

WATER WELL DRILLERS LOG


4-28 1976 Hicks Well Co. State  
 date well completed firm name county well located

LANDOWNER: Patron Wood Jr.	description of formations encountered		from	to
Coldwater Min. (mailing address)	Red Sand + Clay		0	20
	Sand + Gravel		20	45
WELL LOCATION: sec. 17 T 53 N R 9 W E S 3 miles NW of Senatobia (distance) (direction) (nearest town)	Gravel		45	60
	Black Clay + Strip Sand		60	140
	White Sand		140	165
WELL PURPOSE: HOME (home, irrigation, municipal, industrial)				
WELL COMPLETION DATA:				
(1) diameter (inches) 4"				
(2) total depth (feet) 165 ft				
(3) static water level (feet) 60 below top of ground.				
(4) casing Plastic, 165 (material) (depth)				
(size) If telescope see back.				
(5) screen 4 ft, 161 (length) (depth to top)				
4" Gravel (size) (material)				
(6) pump 1/2 (HP) 10 (yield, gpm)				
Electric - 220V. (type power)				
(7) electric log No (yes or no)				
(organization running log)				
(8) how well bottom plugged Cap				
DRILLERS REMARKS:				

JUL 21 1976  
 MISSISSIPPI BOARD OF WATER COMMISSIONERS

If well telescopes please sketch and show depths.

GROUND LEVEL

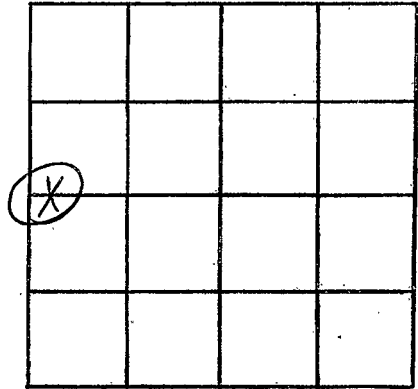

SECTION 17

Please indicate well location X.

ADDITIONAL INFORMATION

If more than one screen,  
show locations of each on sketch.