

TATC  
 F 2016  
 2-10-77

MISSISSIPPI  
 BOARD OF WATER COMMISSIONERS  
 416 North State Street  
 Jackson, Mississippi 39201

WATER WELL DRILLERS LOG

2-10 1977 date well completed  
 Dickwell Co firm name  
 Tate county well located

LANDOWNER: SNOWDEN BARK  
 5900 Populus Ave.  
 Memphis Tenn.  
 (mailing address)

| description of formations encountered | depth |     |
|---------------------------------------|-------|-----|
|                                       | from  | to  |
| Red Clay                              | 0     | 50  |
| White Clay                            | 50    | 100 |
| Black Clay                            | 100   | 120 |
| Gravel & Sand                         | 120   | 135 |
| White Sand                            | 135   | 190 |

WELL LOCATION:  
 sec 28 T 5 N R 8 E  
 7 1/2 miles NE of Coma  
 (distance) (direction) (nearest town)

WELL PURPOSE: Home  
 (home, irrigation, municipal, industrial)

- WELL COMPLETION DATA:
- (1) diameter (inches) 4
  - (2) total depth (feet) 190
  - (3) static water level (feet) 80 below top of ground.
  - (4) casing PVC 190 (material) (depth)
  - (size) If telescope see back.
  - (5) screen 74 183 (length) (depth to top)
  - 4" Gravel type (size) (material)
  - (6) pump 42 10 (HP) (yield gpm)
  - 220V (type power)
  - (7) electric log  NO (yes or no)
  - (organization running log)
  - (8) how well bottom plugged Cap


DRILLERS REMARKS:

RECEIVED  
 FEB 24 1977

MISS. BU. OF WATER CONTROL

If well telescopes please sketch and show depths.

GROUND LEVEL

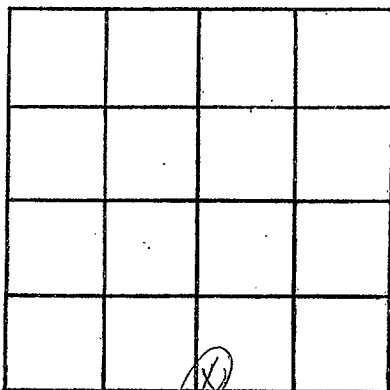

SECTION 28

Please indicate well location X.

ADDITIONAL INFORMATION

Lined area for additional information.

If more than one screen, show locations of each on sketch.