

TATE
 F 2017
 4-27-77

MISSISSIPPI
 BOARD OF WATER COMMISSIONERS
 416 North State Street
 Jackson, Mississippi 39201

WATER WELL DRILLERS LOG

4-27 1977 Harris Bros. Tate
 date well completed firm name county well located

LANDOWNER: Don Beasley
 Rt. 1 Box 57
 Caldwate
 (mailing address)

description of formations encountered	from	to
top soil	0	20
red sand & gravel	20	60
grey clay	60	115
coarse sand	115	140

WELL LOCATION:
 sec. 7 T. 5 N. R. 9 E.
 2 1/2 miles SE of Arabutt
 (distance) (direction) (nearest town)

WELL PURPOSE: none
 (home, irrigation, municipal, industrial)

WELL COMPLETION DATA:

(1) diameter (inches) 4

(2) total depth (feet) 140

(3) static water level (feet) 90 ^{below} ~~above~~ top of ground.

(4) casing Plastic 126
 (material) (depth)
 4 (size) If telescope see back.

(5) screen 14' 126
 (length) (depth to top)
008 plastic
 (size) (material)

(6) pump 3/4 7
 (HP) (yield gpm)
ole.
 (type power)

(7) electric log no
 (yes or no)

(organization running log)

(8) how well bottom plugged solid


DRILLERS REMARKS:

RECEIVED
 MAY 26 1977

MISS. BD. OF WATER COMMISSIONERS

If well telescopes please sketch and show depths.

GROUND LEVEL

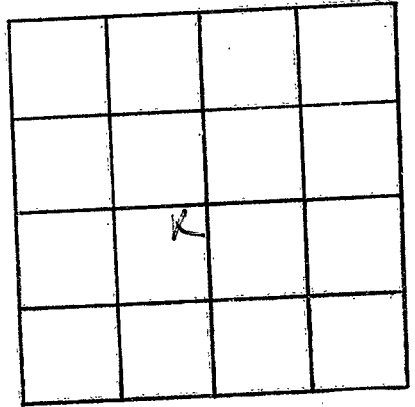

SECTION 7

Please indicate well location X.

ADDITIONAL INFORMATION

If more than one screen,
show locations of each on sketch.