

Tate
 F 2018
 5-19-77

MISSISSIPPI
 BOARD OF WATER COMMISSIONERS
 416 North State Street
 15E Jackson, Mississippi 39201

WATER WELL DRILLERS LOG

5-19 date well completed 1977 Lipe well co firm name Tate county well located

LANDOWNER:
 Thomas Vick
 Charleston MS.
 (mailing address)

description of formations encountered	from	to
Top Soil	0	20
CLAY	20	40
sand	40	60
Gravel	60	80
sand	80	123

WELL LOCATION:
 sec. 12 T 6 N R 8 E
 2 miles north of Senatobia
 (distance) (direction) (nearest town)

WELL PURPOSE:
 (home, irrigation, municipal, industrial)


- WELL COMPLETION DATA:
- (1) diameter (inches) 4
 - (2) total depth (feet) 123
 - (3) static water level (feet) 80 below top of ground.
 - (4) casing PVC, 113 (material), (depth)
 4 (size) if telescope see back.
 - (5) screen 10, 113 (length), (depth to top).
 4 (size), PVC (material)
 - (6) pump 3/4, 10 (HP), (yield gpm).
 elec. (type power)
 - (7) electric log NO (yes or no)
 NO (organization running log)
 - (8) how well bottom plugged PVC CAP

DRILLERS REMARKS:

RECEIVED
 JUN 8 1977
 MISSISSIPPI BOARD OF WATER COMMISSIONERS

If well telescopes please
sketch and show depths.

GROUND LEVEL

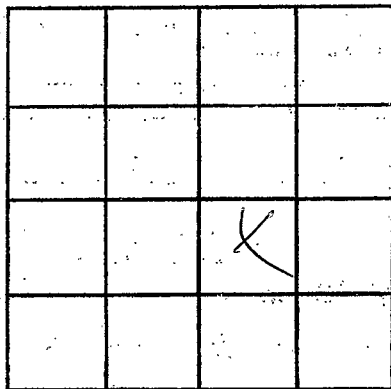

SECTION 12

Please indicate well location X.

ADDITIONAL INFORMATION

If more than one screen,
show locations of each on sketch.