

TATE
 F 2020
 11/26/77

MISSISSIPPI
 BOARD OF WATER COMMISSIONERS
 416 North State Street
 Jackson, Mississippi 39201

WATER WELL DRILLERS LOG

11-26 1977 Harris Bros Tate
 date well completed firm name county well located

LANDOWNER: Jimmy Rainwater
 Rt. 1 Box 4-B
 Coldwater
 (mailing address)

Description of formations encountered	from	to
top soil	0	15
red sand	15	45
clay + sand	45	100
coarse sand	100	120


WELL LOCATION:
 sec. 2 T. 5 N. R. 8 E.
 2 miles W of Coldwater
 (distance) (direction) (nearest town)

WELL PURPOSE: none
 (home, irrigation, municipal, industrial)

- WELL COMPLETION DATA:
- (1) diameter (inches) 4
 - (2) total depth (feet) 120
 - (3) static water level (feet) 80 ^{below} _{above} top of ground.
 - (4) casing Plastic, 113
 (material) (depth)
 4 (size) if telescope see back.
 - (5) screen 7, 113
 (length) (depth to top)
 908, Plastic
 (size) (material)
 - (6) pump 3/4, 10
 (HP) (yield gpm)
 elec.
 (type power)
 - (7) electric log no
 (yes or no)

(organization running log)
 (8) how well bottom plugged solid


DRILLERS REMARKS:

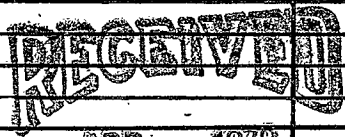

APR - 6 1978

If well telescopes please sketch and show depths.

GROUND LEVEL

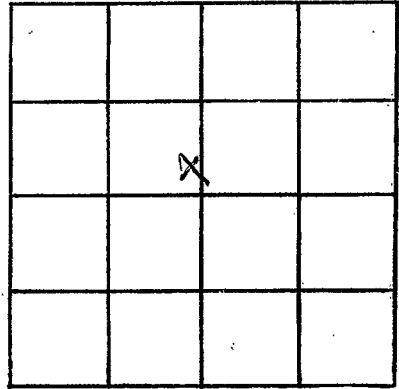

SECTION 2

Please indicate well location X.

ADDITIONAL INFORMATION

If more than one screen, show locations of each on sketch.