

TATE

F 2001

MISSISSIPPI  
BOARD OF WATER COMMISSIONERS  
416 North State Street  
Jackson, Mississippi 39201

WATER WELL DRILLERS LOG

11-17-77 19 date well completed      Sub Smith Well Co firm name      Tate county well located

LANDOWNER:  
Charles White  
Spartan, Miss  
(mailing address)

description of formations encountered	from	to
top soil	0	5
red clay	5	30
sand	30	120

WELL LOCATION:  
sec. 13 T 3 N R 8 E  
1 miles N of Spartan  
(distance) (direction) (nearest town)

WELL PURPOSE:  
(home, irrigation, municipal, industrial)

WELL COMPLETION DATA:

(1) diameter (inches) 4"

(2) total depth (feet) 120

(3) static water level (feet) 50 below top of ground

(4) casing (material) plastic (depth) 120  
(size) If telescope see back.

(5) screen (length) 10 (depth to top) 110  
4" (size) plastic (material)

(6) pump (HP) 3/4 (yield gpm) 10  
Electric (type power)

(7) electric log (yes or no)  no  
(organization running log)

(8) how well bottom plugged

DRILLERS REMARKS:


RECEIVED

MAY 30 1978

MISS. BD. OF WATER COMM

If well telescopes please sketch and show depths.

GROUND LEVEL

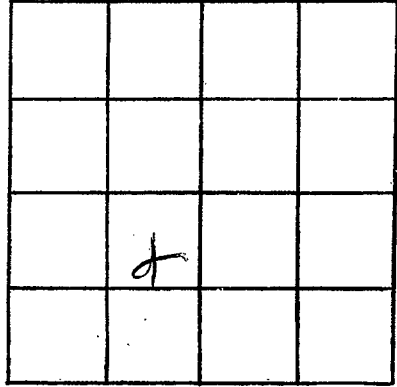

SECTION \_\_\_\_\_

Please indicate well location X.

ADDITIONAL INFORMATION

If more than one screen,  
show locations of each on sketch.