

TATE
 F 2022
 6/20/78

MISSISSIPPI
 BOARD OF WATER COMMISSIONERS
 416 North State Street
 Jackson, Mississippi 39201

WATER WELL DRILLERS LOG

6-20-78 19 JRB Cain Tate
 date well completed firm name county well located


LANDOWNER: Pantecostal Church Sanatobia Miss
 (mailing address)

description of formations encountered	from	to
Clay	0	15
Sand	15	22
Gravel	22	45
Clay	45	60
Sand	60	115

WELL LOCATION:
 sec 25 T 5 N R 8 E
1 miles SW of Sanatobia
 (distance) (direction) (nearest town)

WELL PURPOSE: Church
 (home, irrigation, municipal, industrial)


- WELL COMPLETION DATA:
- (1) diameter (inches) 4
 - (2) total depth (feet) 115
 - (3) static water level (feet) 60 below top of ground.
 - (4) casing Plastic 1 1/2
 (material) (depth)
 (size) If telescope see back.
 - (5) screen 10' 10 1/2'
 (length) (depth to top)
4" Plastic
 (size) (material)
 - (6) pump 3/4 100
 (HP) (yield gpm)
Elect
 (type power)
 - (7) electric log (yes or no) _____
 (organization running log) _____
 - (8) how well bottom plugged Plug

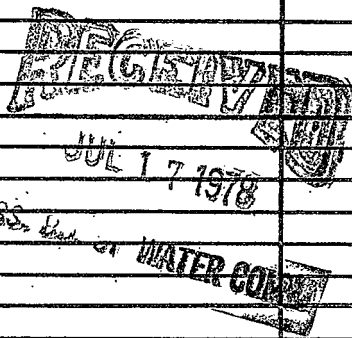

DRILLERS REMARKS:

If well telescopes please sketch and show depths.

GROUND LEVEL

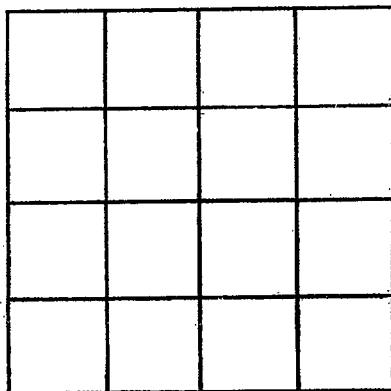

SECTION _____

Please indicate well location X.

ADDITIONAL INFORMATION

If more than one screen, show locations of each on sketch.