

TATE
F 2023

**MISSISSIPPI  
BOARD OF WATER COMMISSIONERS**  
416 North State Street  
Jackson, Mississippi 39201

**WATER WELL DRILLERS LOG**

7-11 1978 Hicks Well Co Tate  
 date well completed firm name county well located

LANDOWNER: <u>Don Faulkner</u>	description of formations encountered	from	to
<u>Caldwater, Mo.</u> (mailing address)	<u>Red Clay</u>	<u>3</u>	<u>20</u>
<b>WELL LOCATION:</b> SEC <u>11</u> T <u>5</u> N <u>8</u> E <u>W</u> <u>2</u> miles <u>SE</u> of <u>Caldwater</u> (distance) (direction) (nearest town)	<u>White Clay Sand</u>	<u>20</u>	<u>45</u>
<b>WELL PURPOSE:</b> <u>Home</u> (home, irrigation, municipal, industrial)	<u>White Sand</u>	<u>45</u>	<u>98</u>
<b>WELL COMPLETION DATA:</b>			
(1) diameter (inches) <u>4</u>			
(2) total depth (feet) <u>95</u>			
(3) static water level (feet) <u>40</u> below top of ground.			
(4) casing <u>PVC</u> (material) <u>95</u> (depth)			
<u>    </u> if telescope see back.			
(size)			
(5) screen <u>4</u> (length) <u>91</u> (depth to top)			
<u>4"</u> (size) <u>ground type</u> (material)			
(6) pump <u>1/2</u> (HP) <u>1.0</u> (yield gpm)			
<u>220V</u> (type power)			
(7) electric log <u>No</u> (yes or no)			
(organization running log)			
(8) how well bottom plugged <u>Cap</u>			
<b>DRILLERS REMARKS:</b>			


**RECEIVED**

JUL 21 1978

MISS. BD. OF WATER COMM.

If well telescopes please sketch and show depths.

GROUND LEVEL

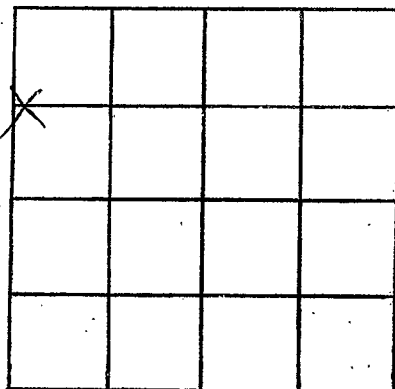

SECTION 11

Please indicate well location X.

ADDITIONAL INFORMATION

If more than one screen,  
show locations of each on sketch.